


Consultant: Elena Osborne

Date: 27/08/2019

Project Description: Site Inspection

Matter #: 015035001

Address: 270 Willis St, Bistros on Willies

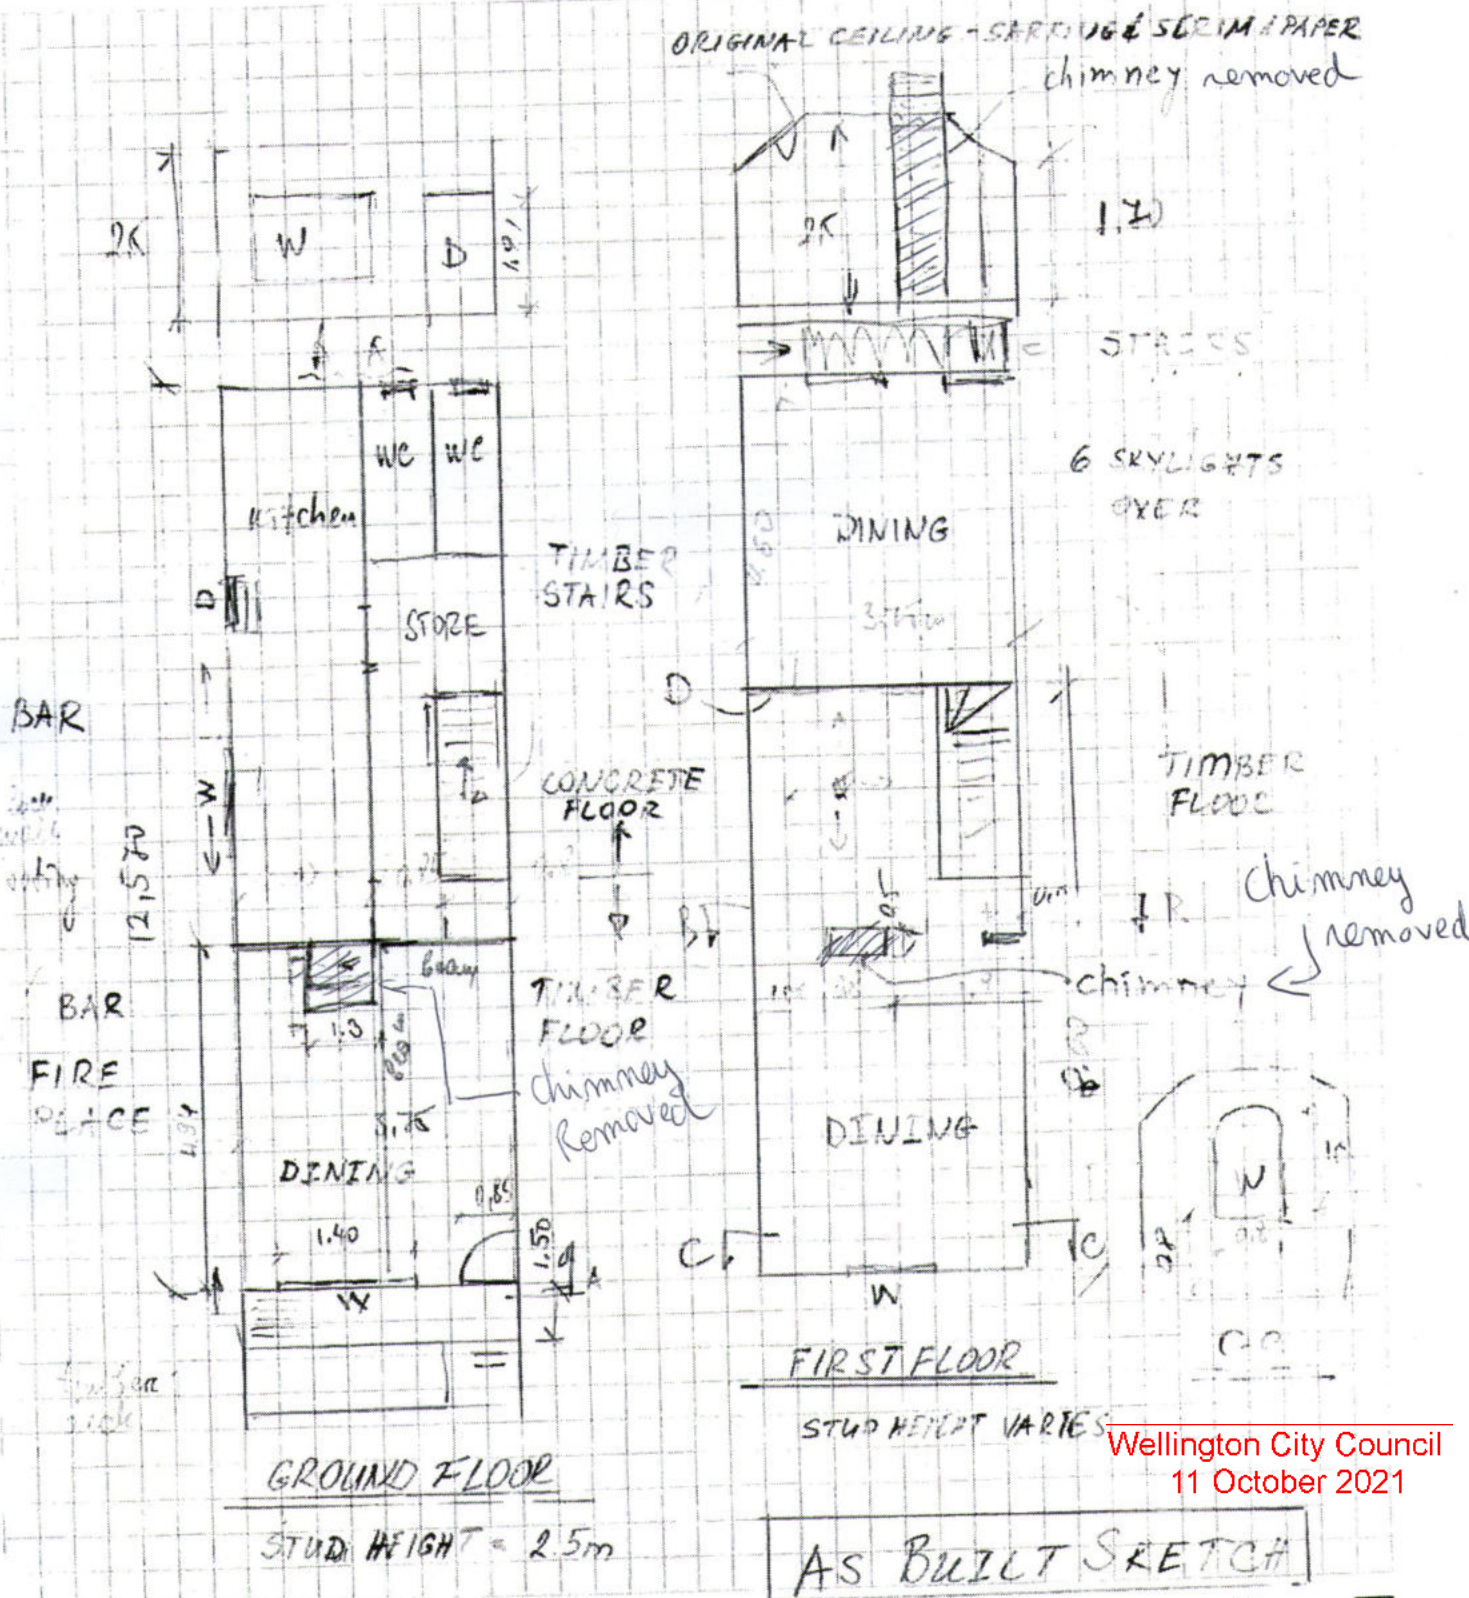

Wellington City Council
11 October 2021

AS BUILT SKETCH

