

Licensed area - No Designation

Main Entrance

Outdoor covered area

3 unisex toilets incl. 1 disabled

Tennyson Street

FOOD ENVY FITOUT

Project Location 25-29 Tennyson Street, Te Aro Client FOOD ENVY LTD

Rev.	Date	Description
G	15/12/2020	AS-BUILT
F	05/12/2019	BUILDING CONSENT RFI 1
E	22/10/2019	BUILDING CONSENT
D	07/10/2019	Door swing updated
C	01/10/2019	Plan updated
B	24/09/2019	Indicative Pump Location
A	05/07/2019	Indicative Hood Location



rêve architecture LTD
 www.revearchitecture.co.nz
 t. 021 900 982
 e. enquiries@revearchitecture.co.nz
 p. PO Box 27161 Wellington 6141 NZ

Issued for: WCC INFORMATION

Sheet Title PROPOSED FLOOR PLAN

Sheet No. A-1.01 G
 Job No. 1934
 Scale 1:50 @ A1, 1:100 @ A3

- NOTES:
- Do not scale drawings. Use figured dimensions only.
 - Contractor to verify all dimensions on site before commencing work.
 - Contractor to report any discrepancy for interpretation to the Architect prior to affected work proceeding.
 - © COPYRIGHT ON THIS DRAWING IS RESERVED

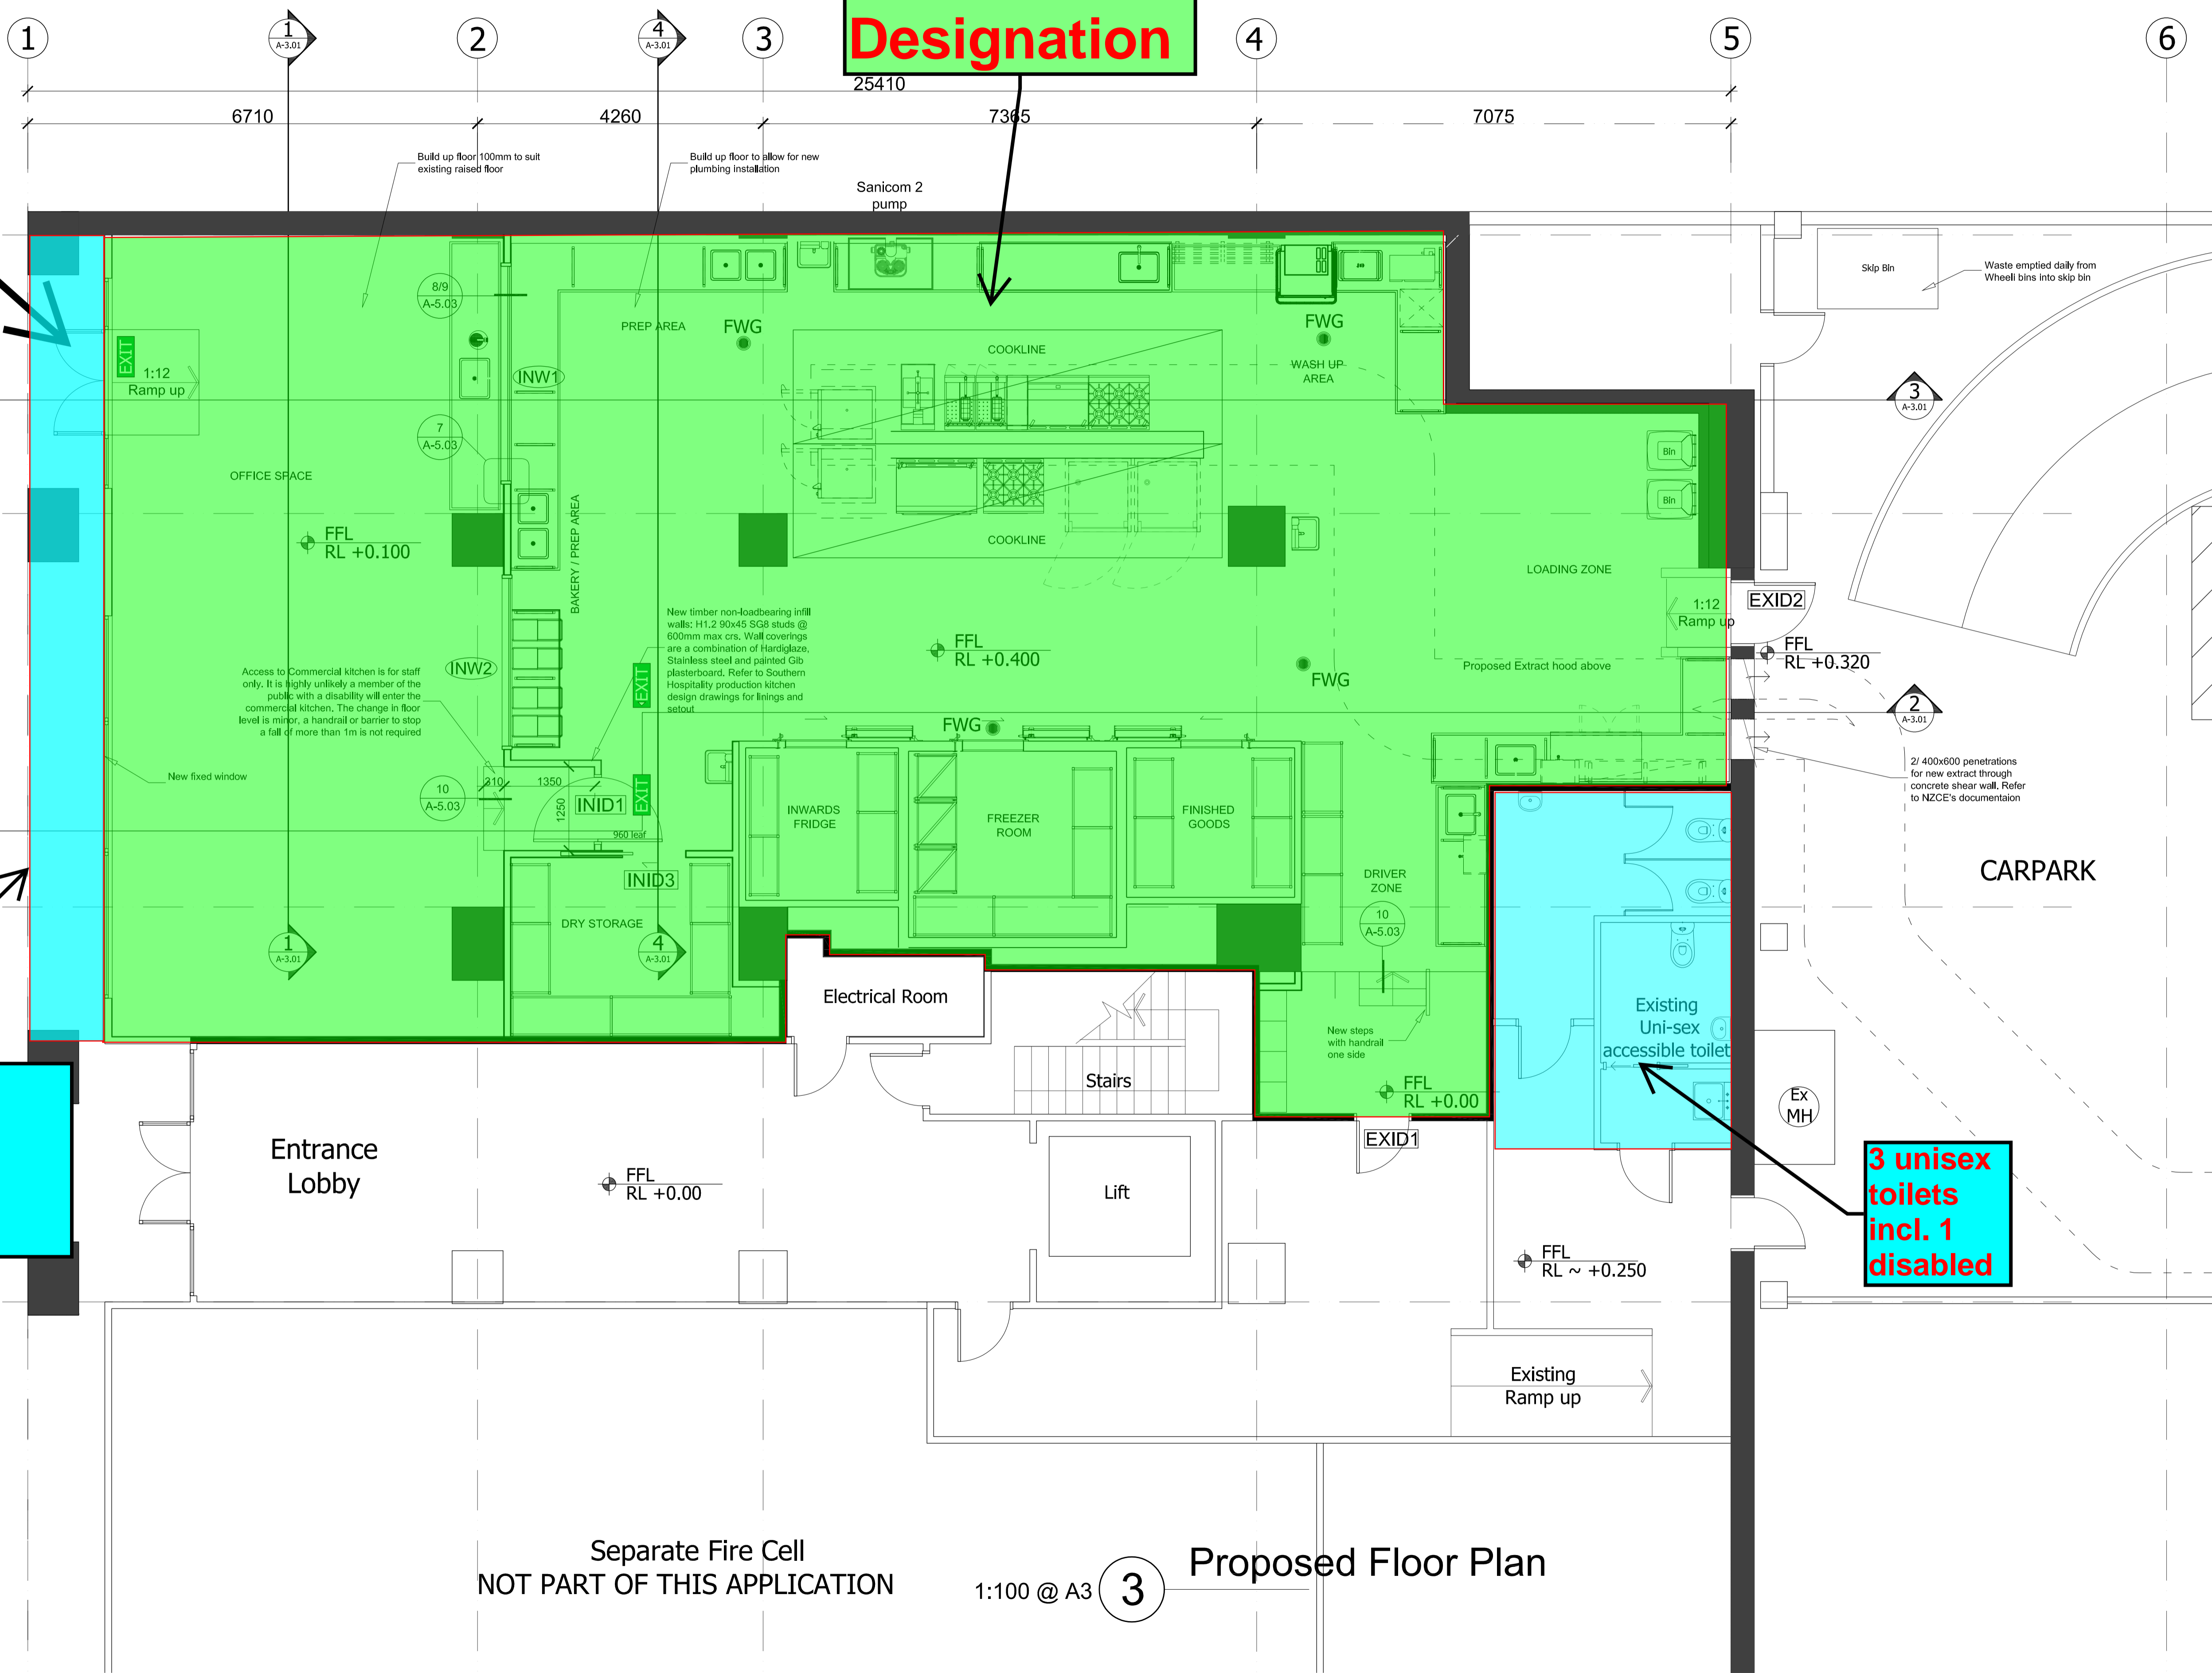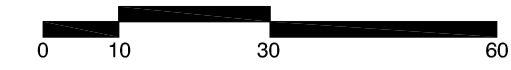

1:100 @ A3 3 Proposed Floor Plan

Wellington City Council Received: 04/08/2022