




STEWART DRIVE  
Legal Road

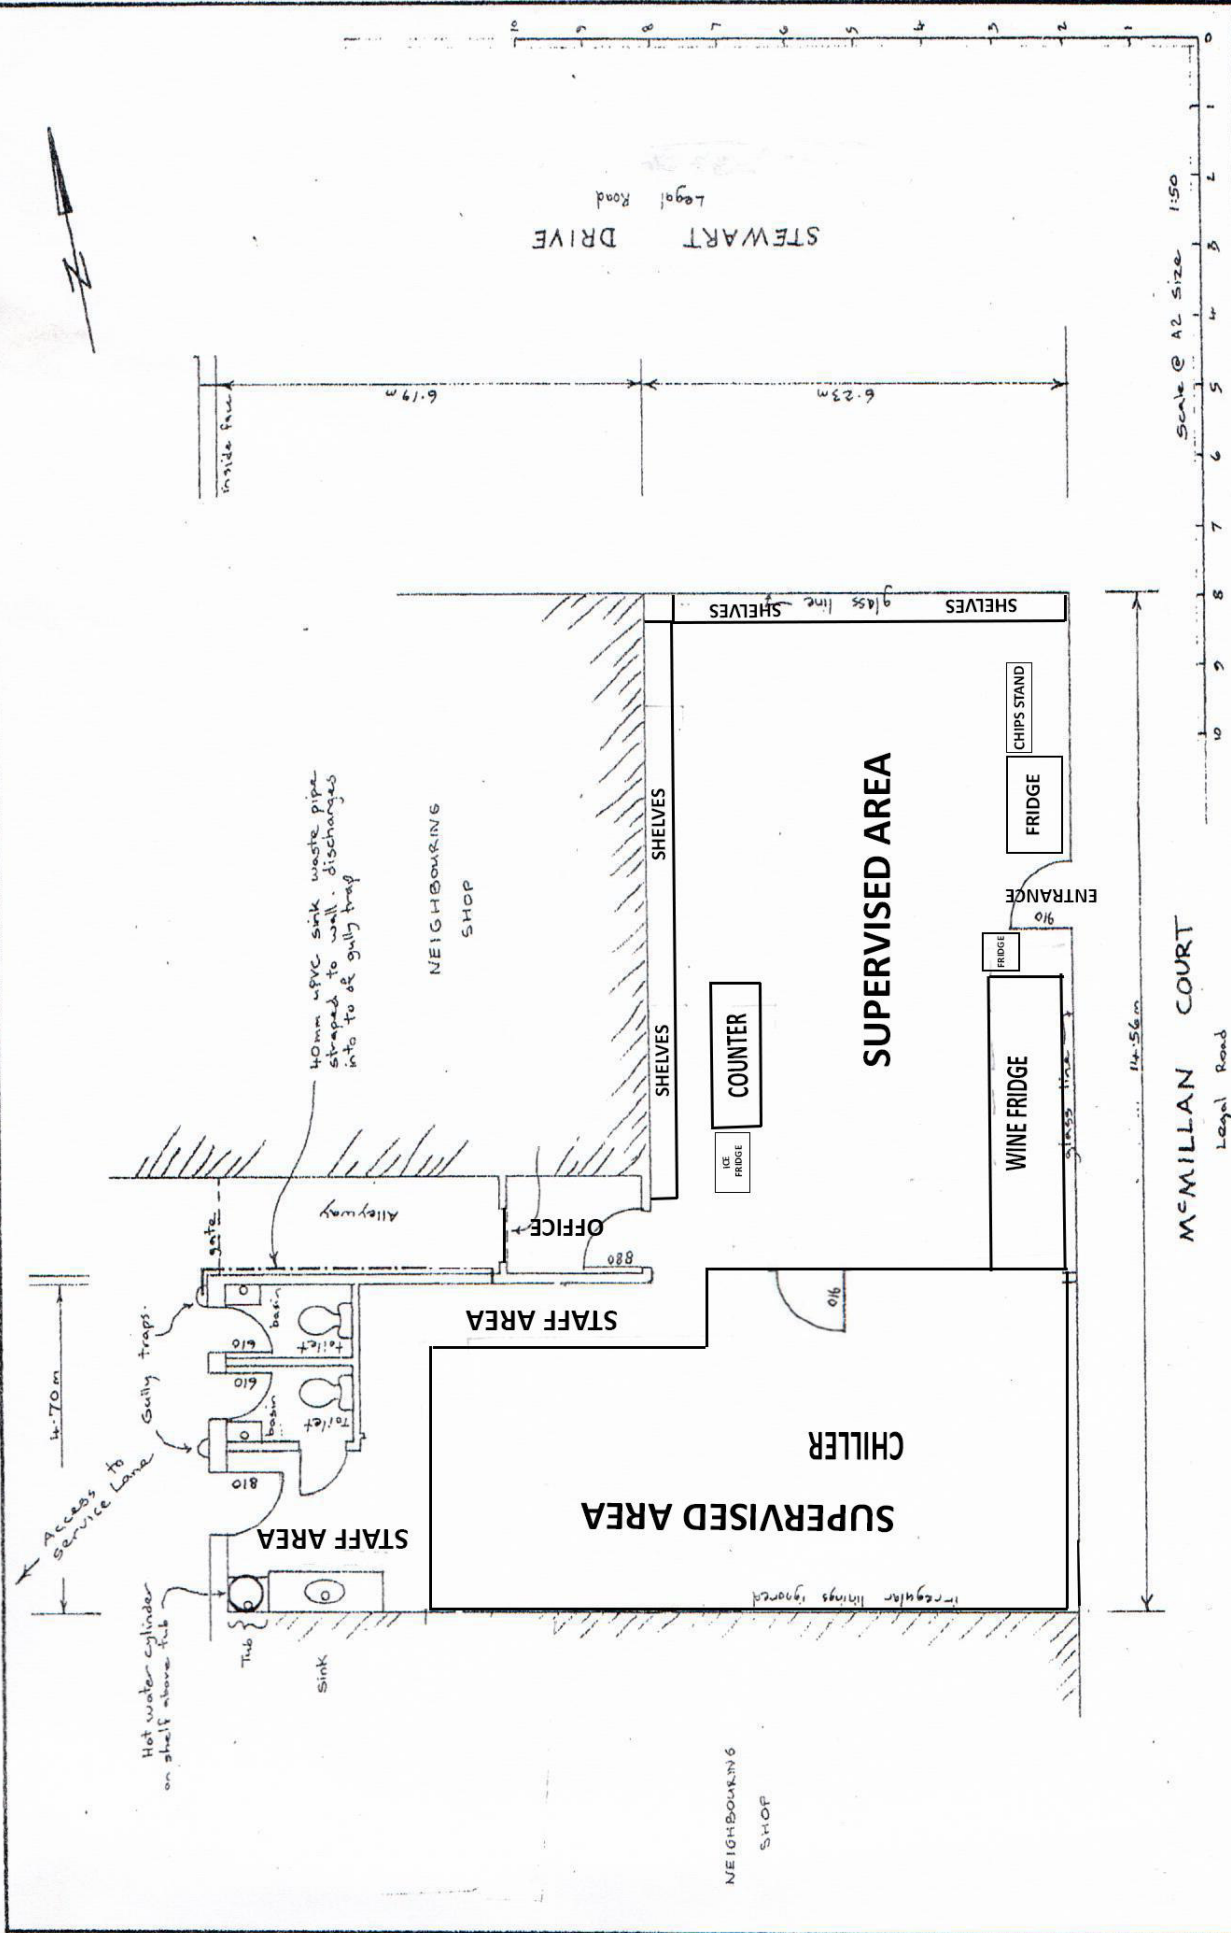

Scale @ A2 Size 1:50

McMILLAN COURT  
Legal Road

OWNER	AMENDMENT	NO. OF SHEETS	NO. OF THIS SHEET
PHIK	PHIK	1	1
PHIK	PHIK	1:50	1:50
DATE 26/3/08	DATE 26/3/08		
			508

Shop on corner of Stewart Drive & McMillan Court  
"AS BUILT" PLAN AS OF 26<sup>th</sup> MARCH 2008  
Located on Lot 3 DP 27667