



Wellington City Council
21 April 2021

Principle Entrance

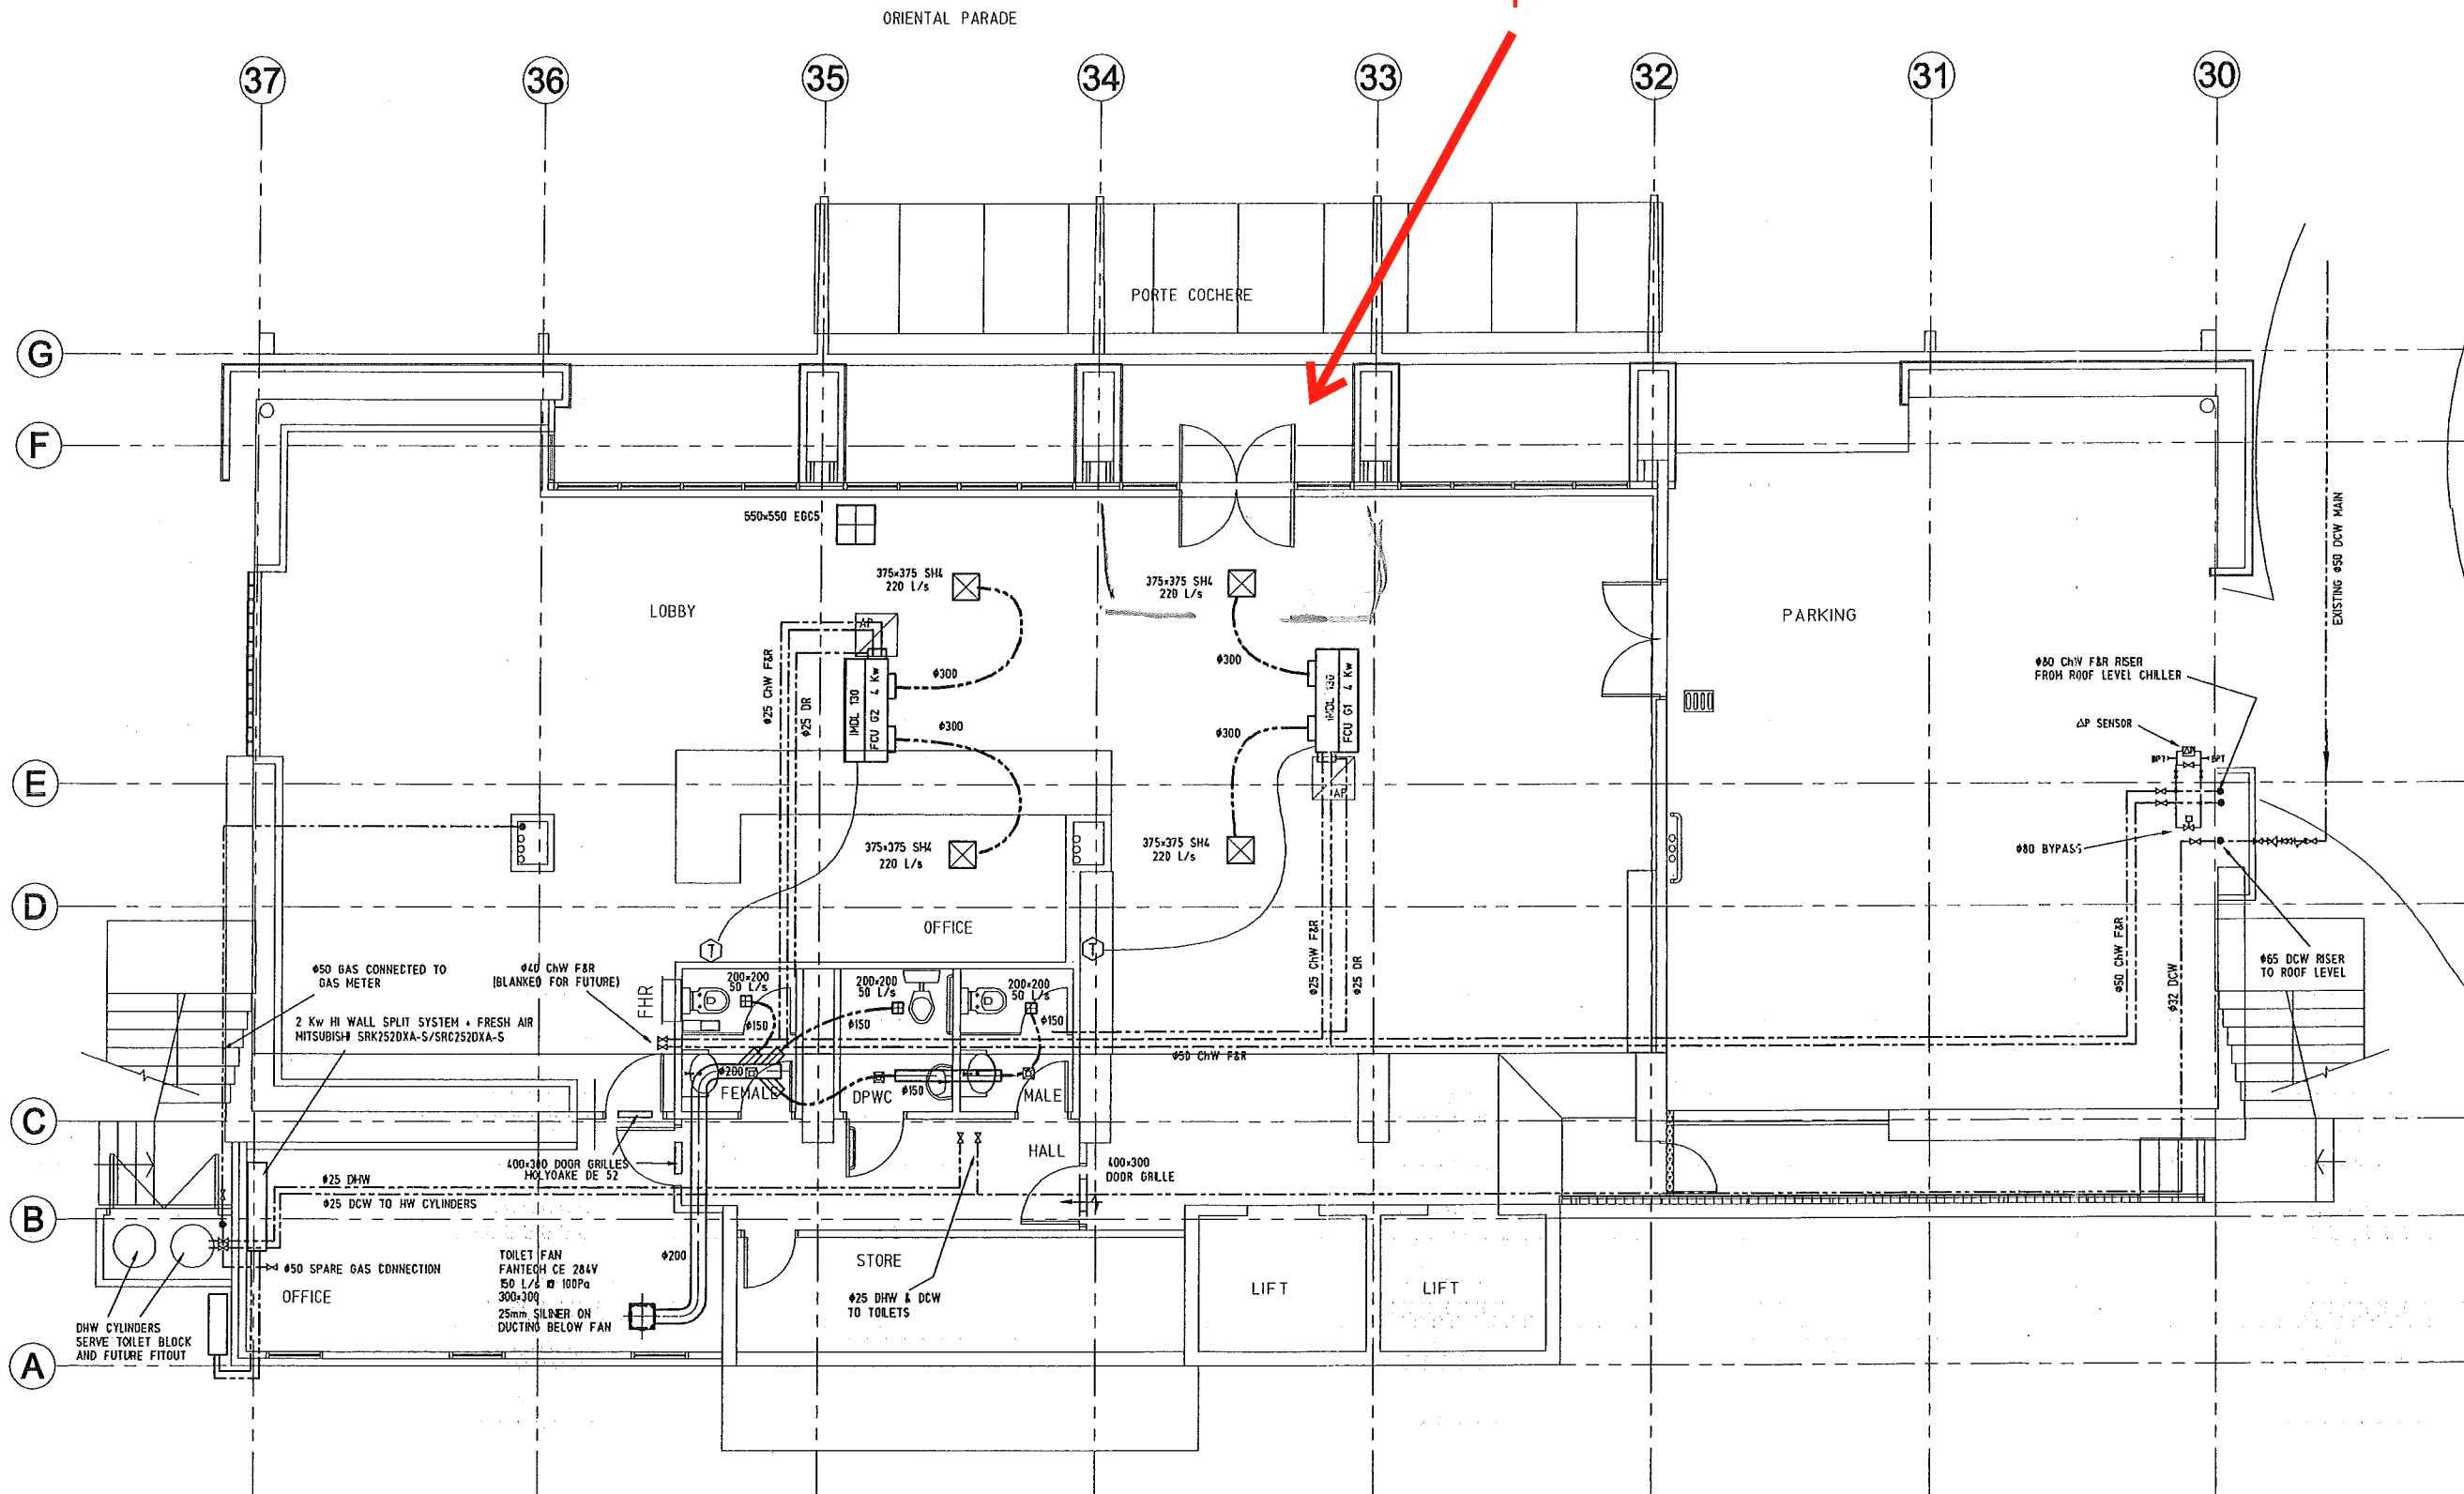

Ground Floor - Not Licenced

Issue	Amendments
<p>AS BUILT DRAWING DECEMBER 2020 THIS DRAWING IS A TRUE AND CORRECT RECORD OF THE AS INSTALLED SERVICES SYSTEM Signed: _____</p>	
<p>Stamp: AS BUILT DRAWING</p>	
Status of Drawing:	Author:
PRELIMINARY	
FOR APPROVAL	
FOR CONSTRUCTION	
<p>Copyright © This Document and the Copyright Property of Economech Services Ltd. No part of this Document may be reproduced by any means, whatsoever without the prior written consent of Economech Services Ltd.</p>	
<p>ECONOMECH P.O. BOX 14048 PH: (09) 579-1414 Email: al@economech.co.nz</p>	
<p>AIR CONDITIONING & HEATING</p>	
<p>Project Title: KING ORIENT WELL</p>	
<p>Sheet Title: MECHANICAL BALANCE</p>	
Drawn:	RC
Date:	OCT'07
Drawing No:	14

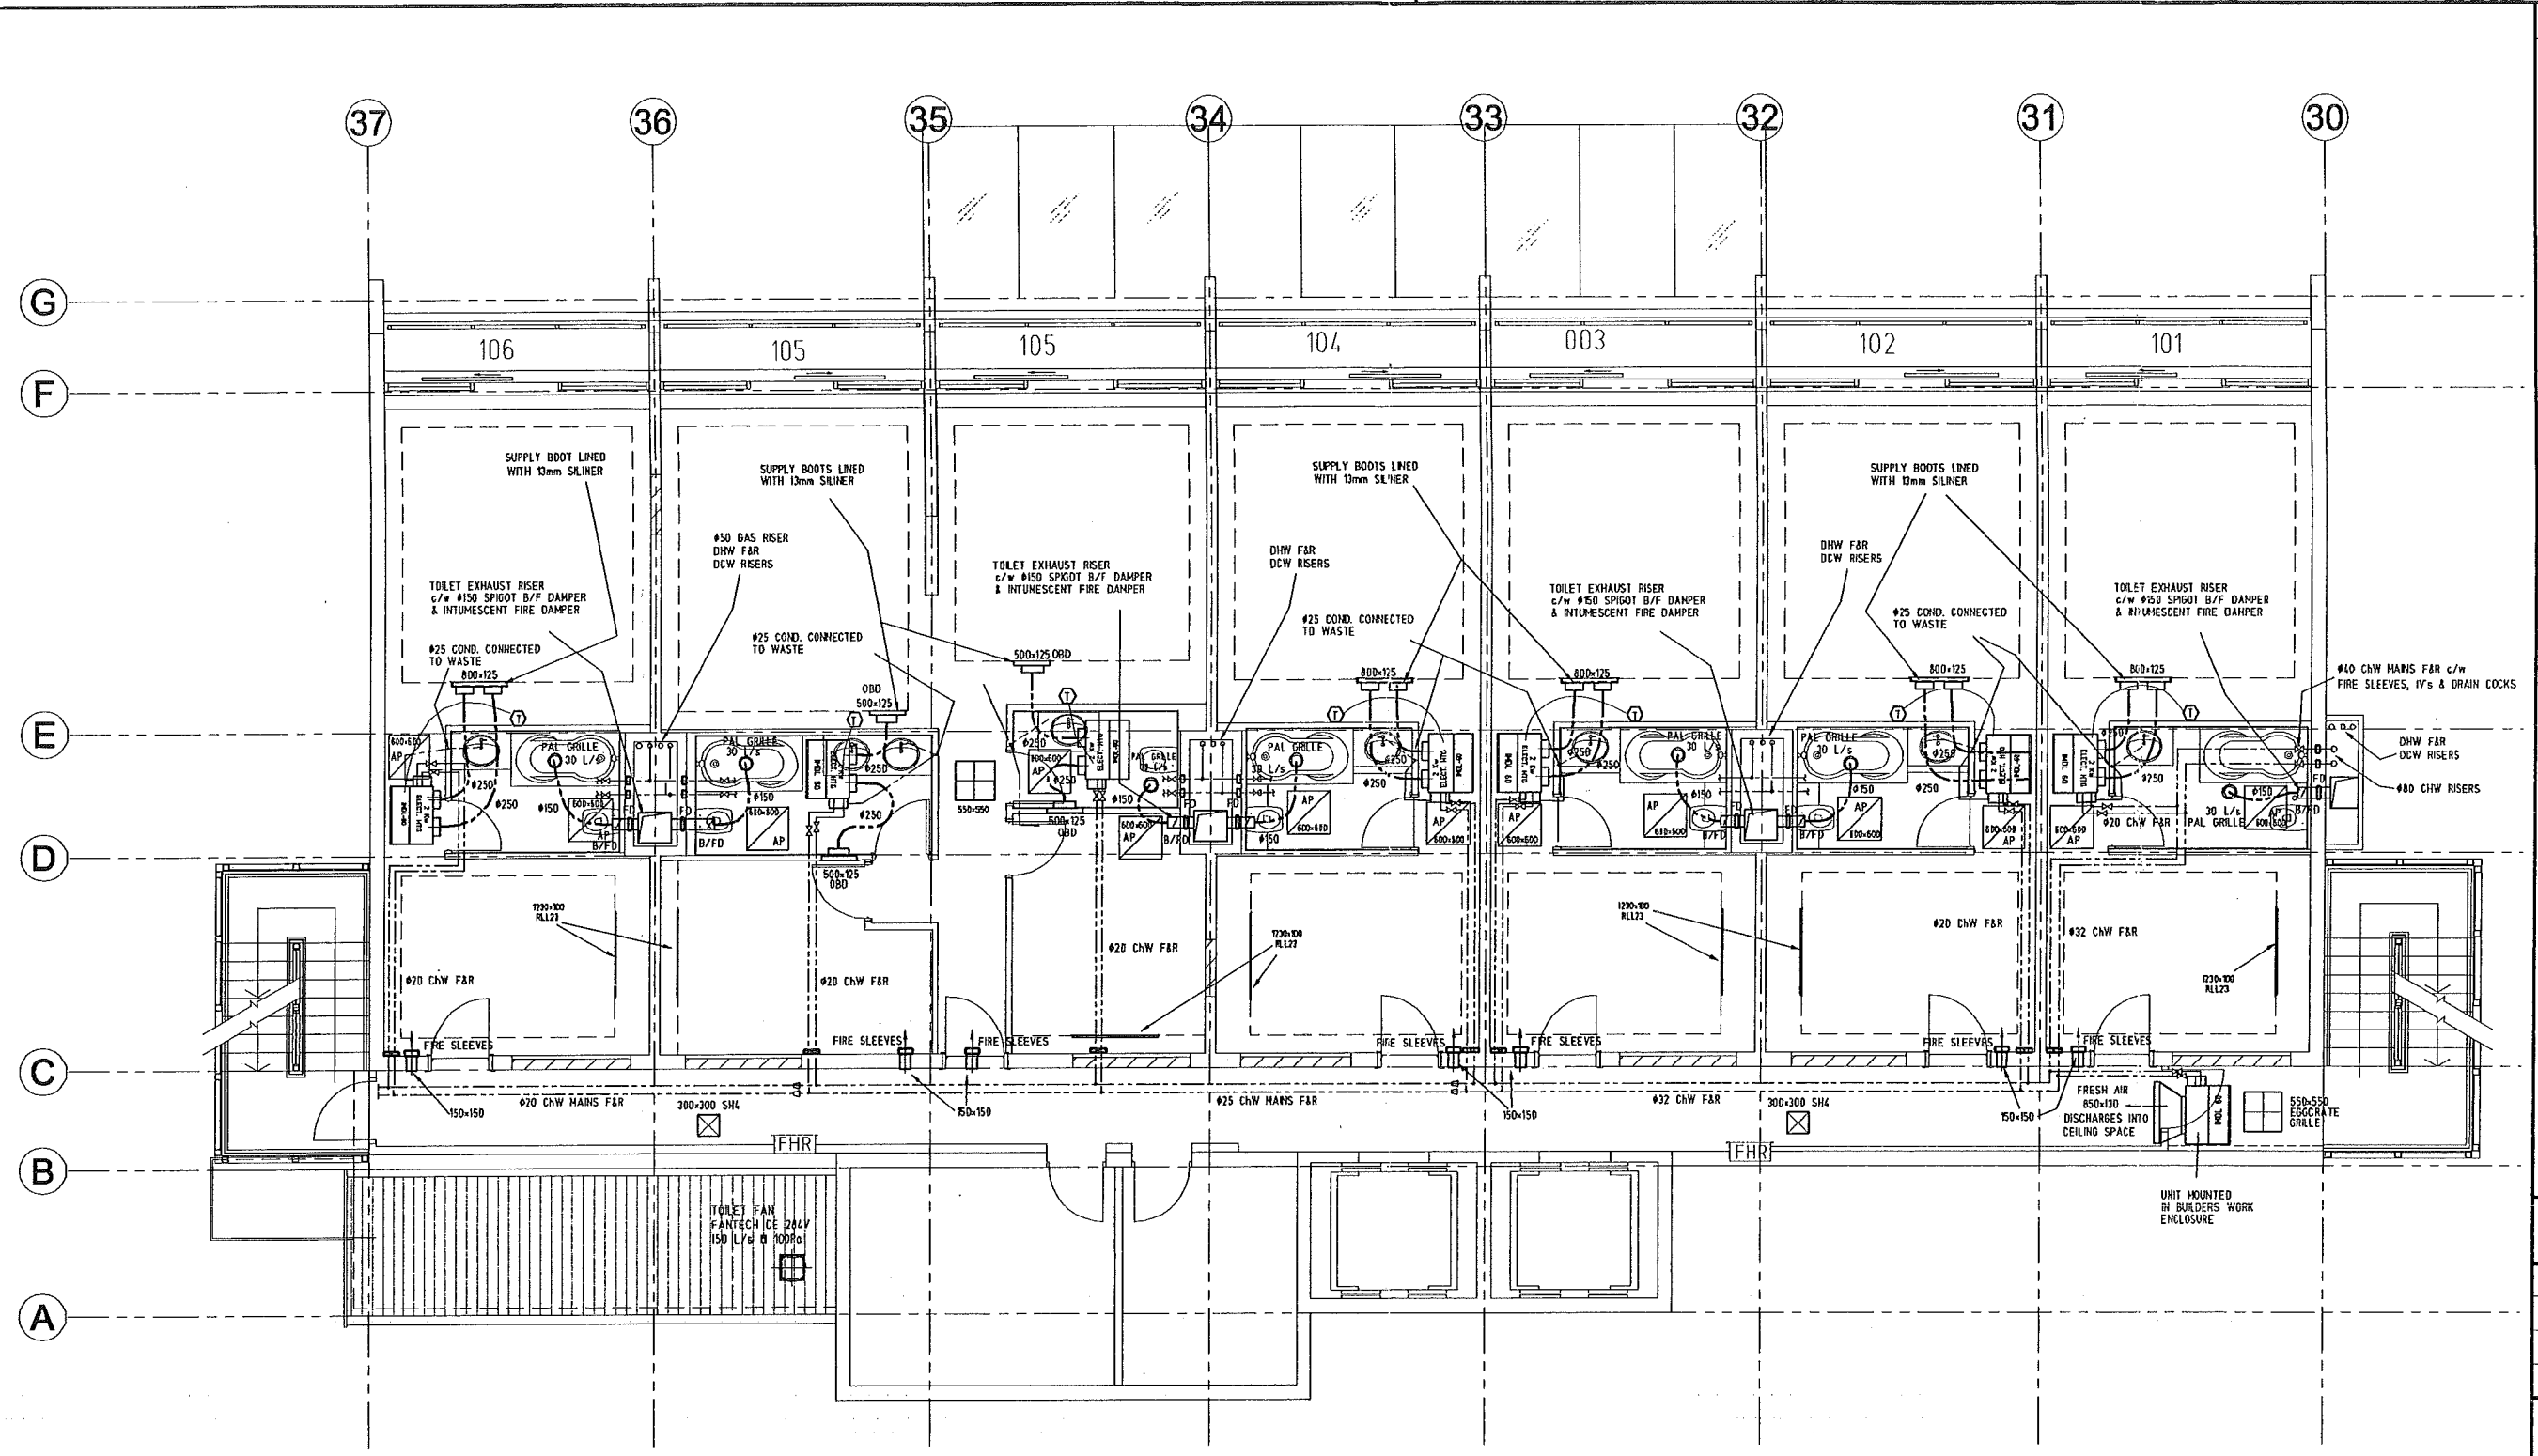

Issue	Amendments	Date	Sign

AS BUILT DRAWING
DECEMBER 2007
THIS DRAWING IS A TRUE AND ACCURATE
RECORD OF THE AS INSTALLED MECHANICAL
SERVICES SYSTEM
Signed WH

AS BUILT DRAWING

Status of Drawing	Authorised Sign	Date
PRELIMINARY -		
FOR APPROVAL -		
FOR CONSTRUCTION -		

COPYRIGHT
This Document and the Copyright in this Document remain the
Property of Economech Services Ltd. The Contents of this
Document may not be reproduced either in whole or in part,
by any means whatsoever without the prior written consent of
Economech Services Ltd.

ECONOMECH SERVICES LTD
P.O. BOX 10218 PARNHUR, AUCKLAND, NZ
Ph: (09) 579-1444 Fax: (09) 579-2308
Email: aircon@economech.co.nz

AIR CONDITIONING, REFRIGERATION
& HEATING ENGINEERS

Project Title:
**KINGSGATE
ORIENTAL BAY
WELLINGTON**


Sheet Title:
**MECHANICAL SERVICES
BAY WING
LEVEL 1**

Drawn: **RC** Conf. Pts: **M04-1404**


Date: **OCT'07** Scale at A1: **1:25**
Scale at A3: **1:50**

Drawing No: **1404-B1** Rev: **-**


**Wellington City Council
21 April 2021**

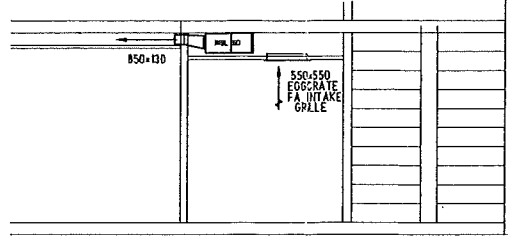

SECTION SHOWING FRESH AIR UNIT ENCLOSURE

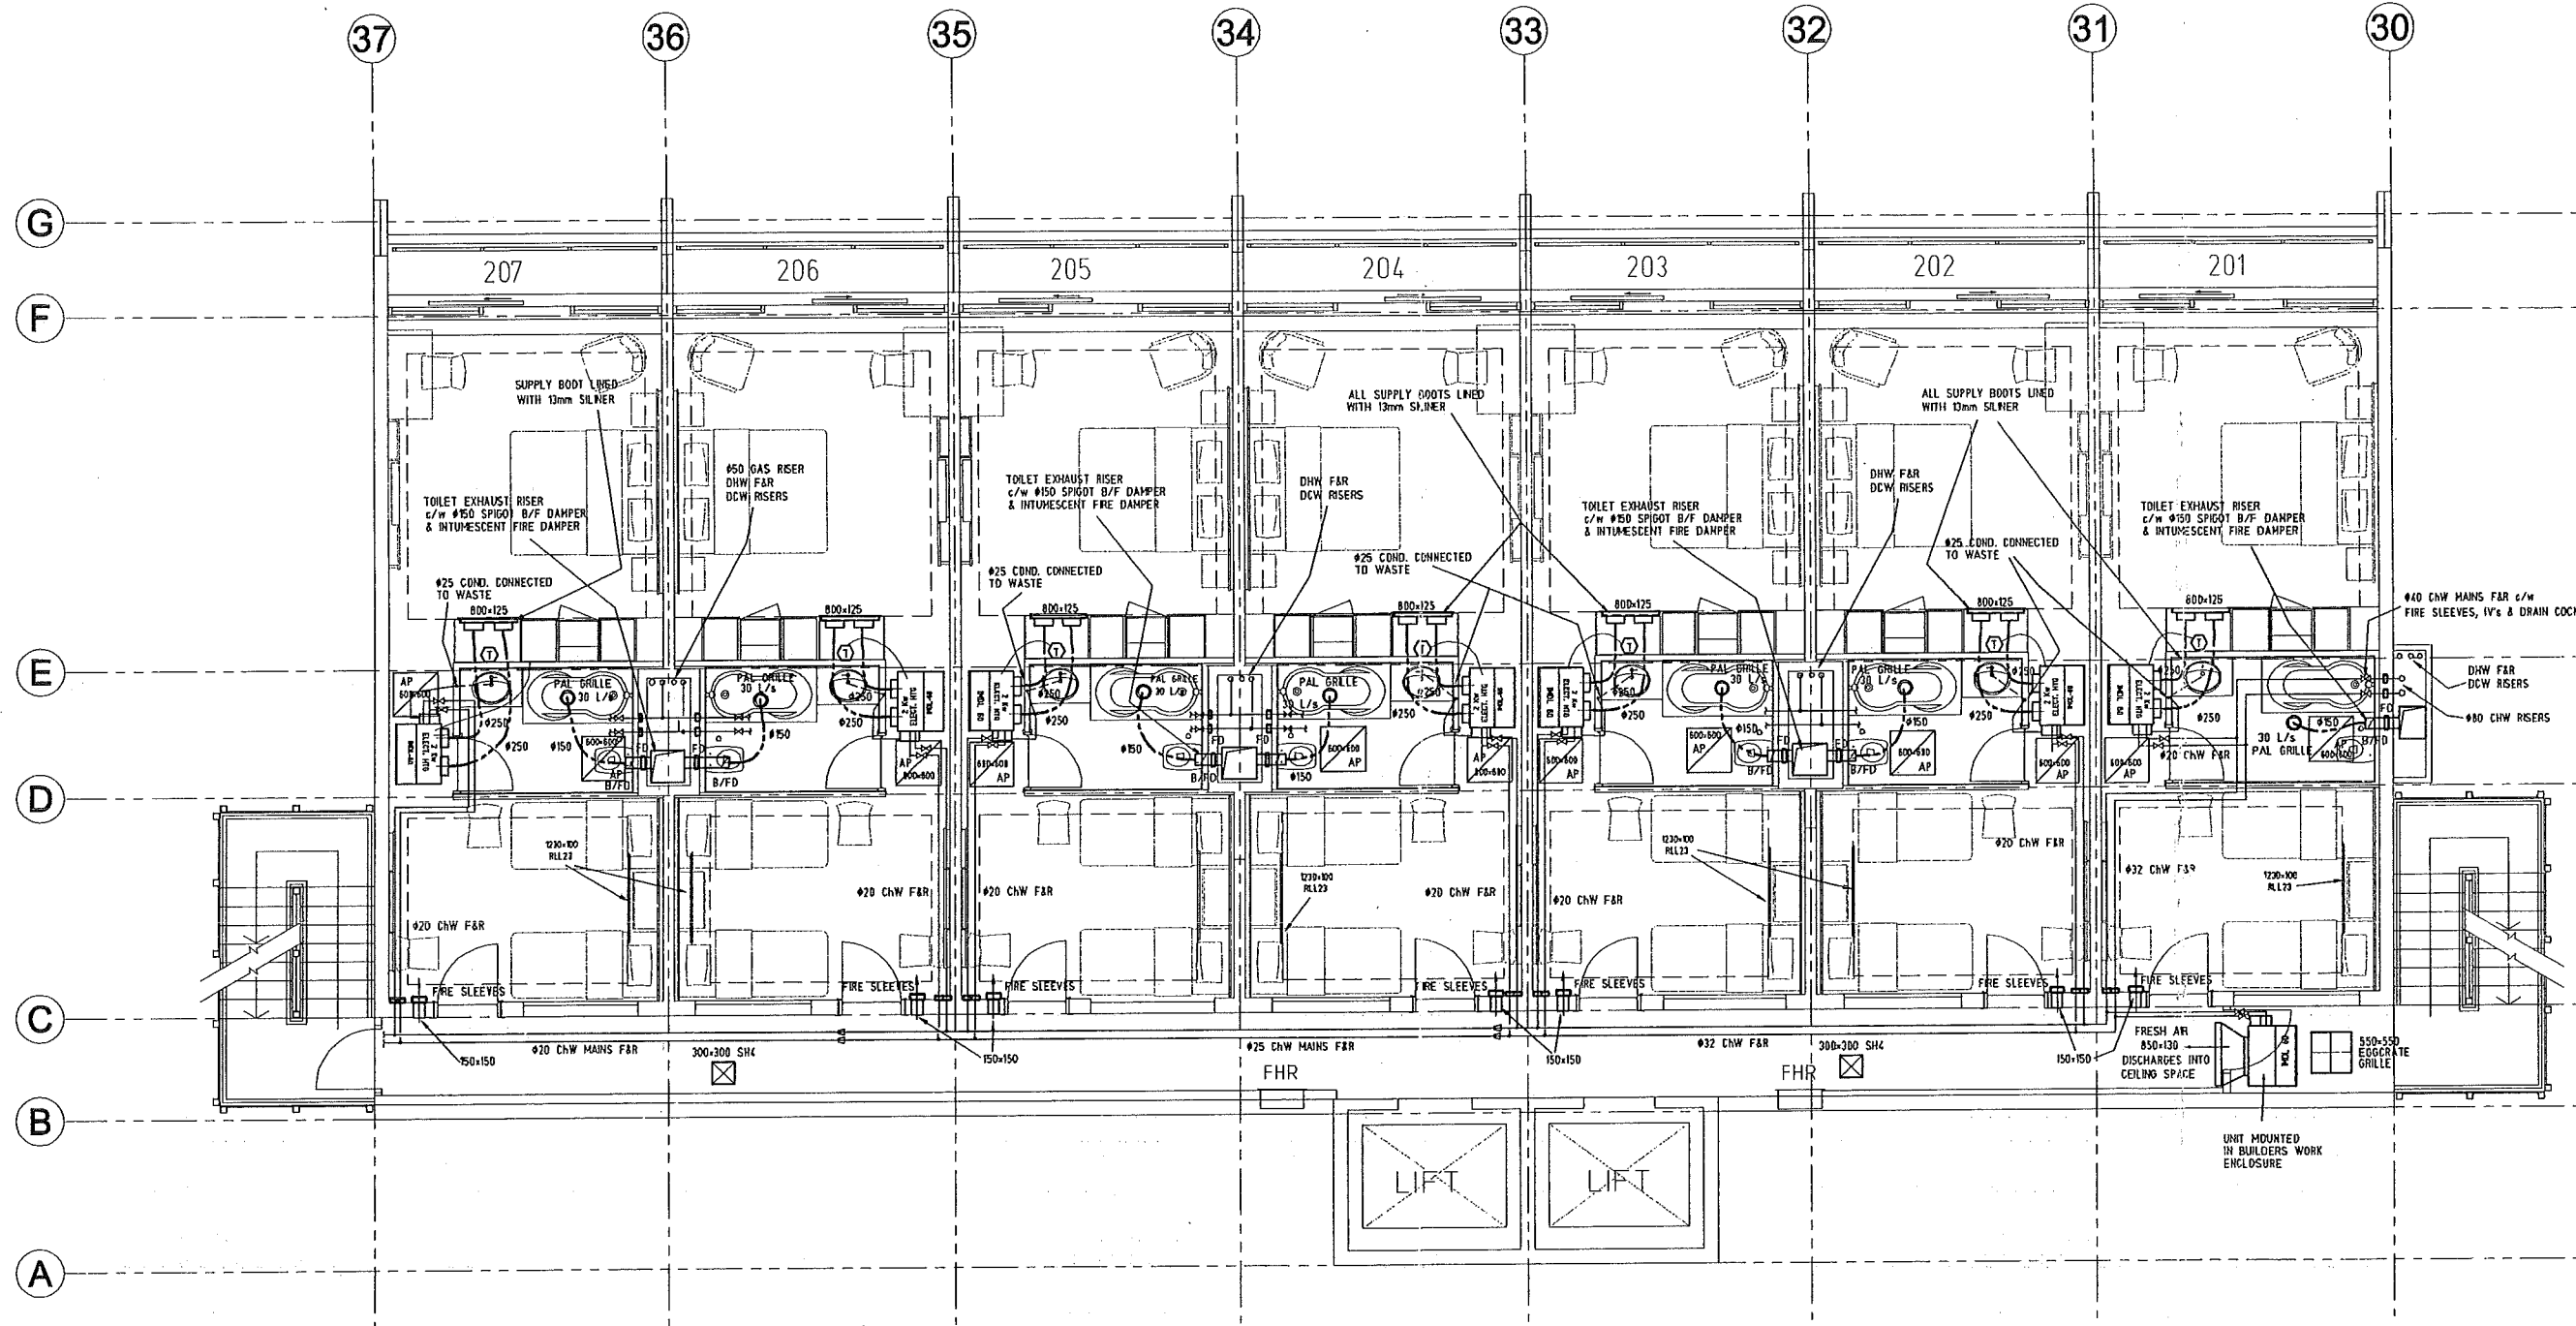

Wellington City Council
21 April 2021

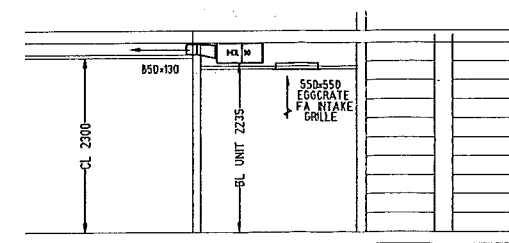

SECTION SHOWING FRESH AIR UNIT ENCLOSURE

Rev	Amendments	Date	Sign

AS BUILT DRAWING
DECEMBER 2007
THIS DRAWING IS A TRUE AND ACCURATE
RECORD OF THE AS INSTALLED MECHANICAL
SERVICES SYSTEM
Signed: WH

Stamp:
AS BUILT DRAWING

Status of Drawing:	Authorised Sign:	Date:
PRELIMINARY -		
FOR APPROVAL -		
FOR CONSTRUCTION -		

COPYRIGHT
This Document and the Copyright in this Document remain the
Property of Economech Services Ltd. The Contents of this
Document may not be reproduced either in whole or in part,
by any means, whatsoever without the prior written consent of
Economech Services Ltd.


ECONOMECH SERVICES LTD
P.O. BOX 10014 PARNHUR, AUCKLAND, NZ
Ph: (09) 573-1444 Fax: (09) 573-2308
Email: aircon@economech.co.nz

**AIR CONDITIONING, REFRIGERATION
& HEATING ENGINEERS**


Project Title:
**KINGSGATE
ORIENTAL BAY
WELLINGTON**

Sheet Title:
**MECHANICAL SERVICES
BAY WING
LEVEL 2**

Drawn: RC	Code File: 1404-B2.dwg
Date: OCT'07	Scale of A1: 1:25 Scale of A3: 1:50
Drawing No: 1404-B2	Rev: -

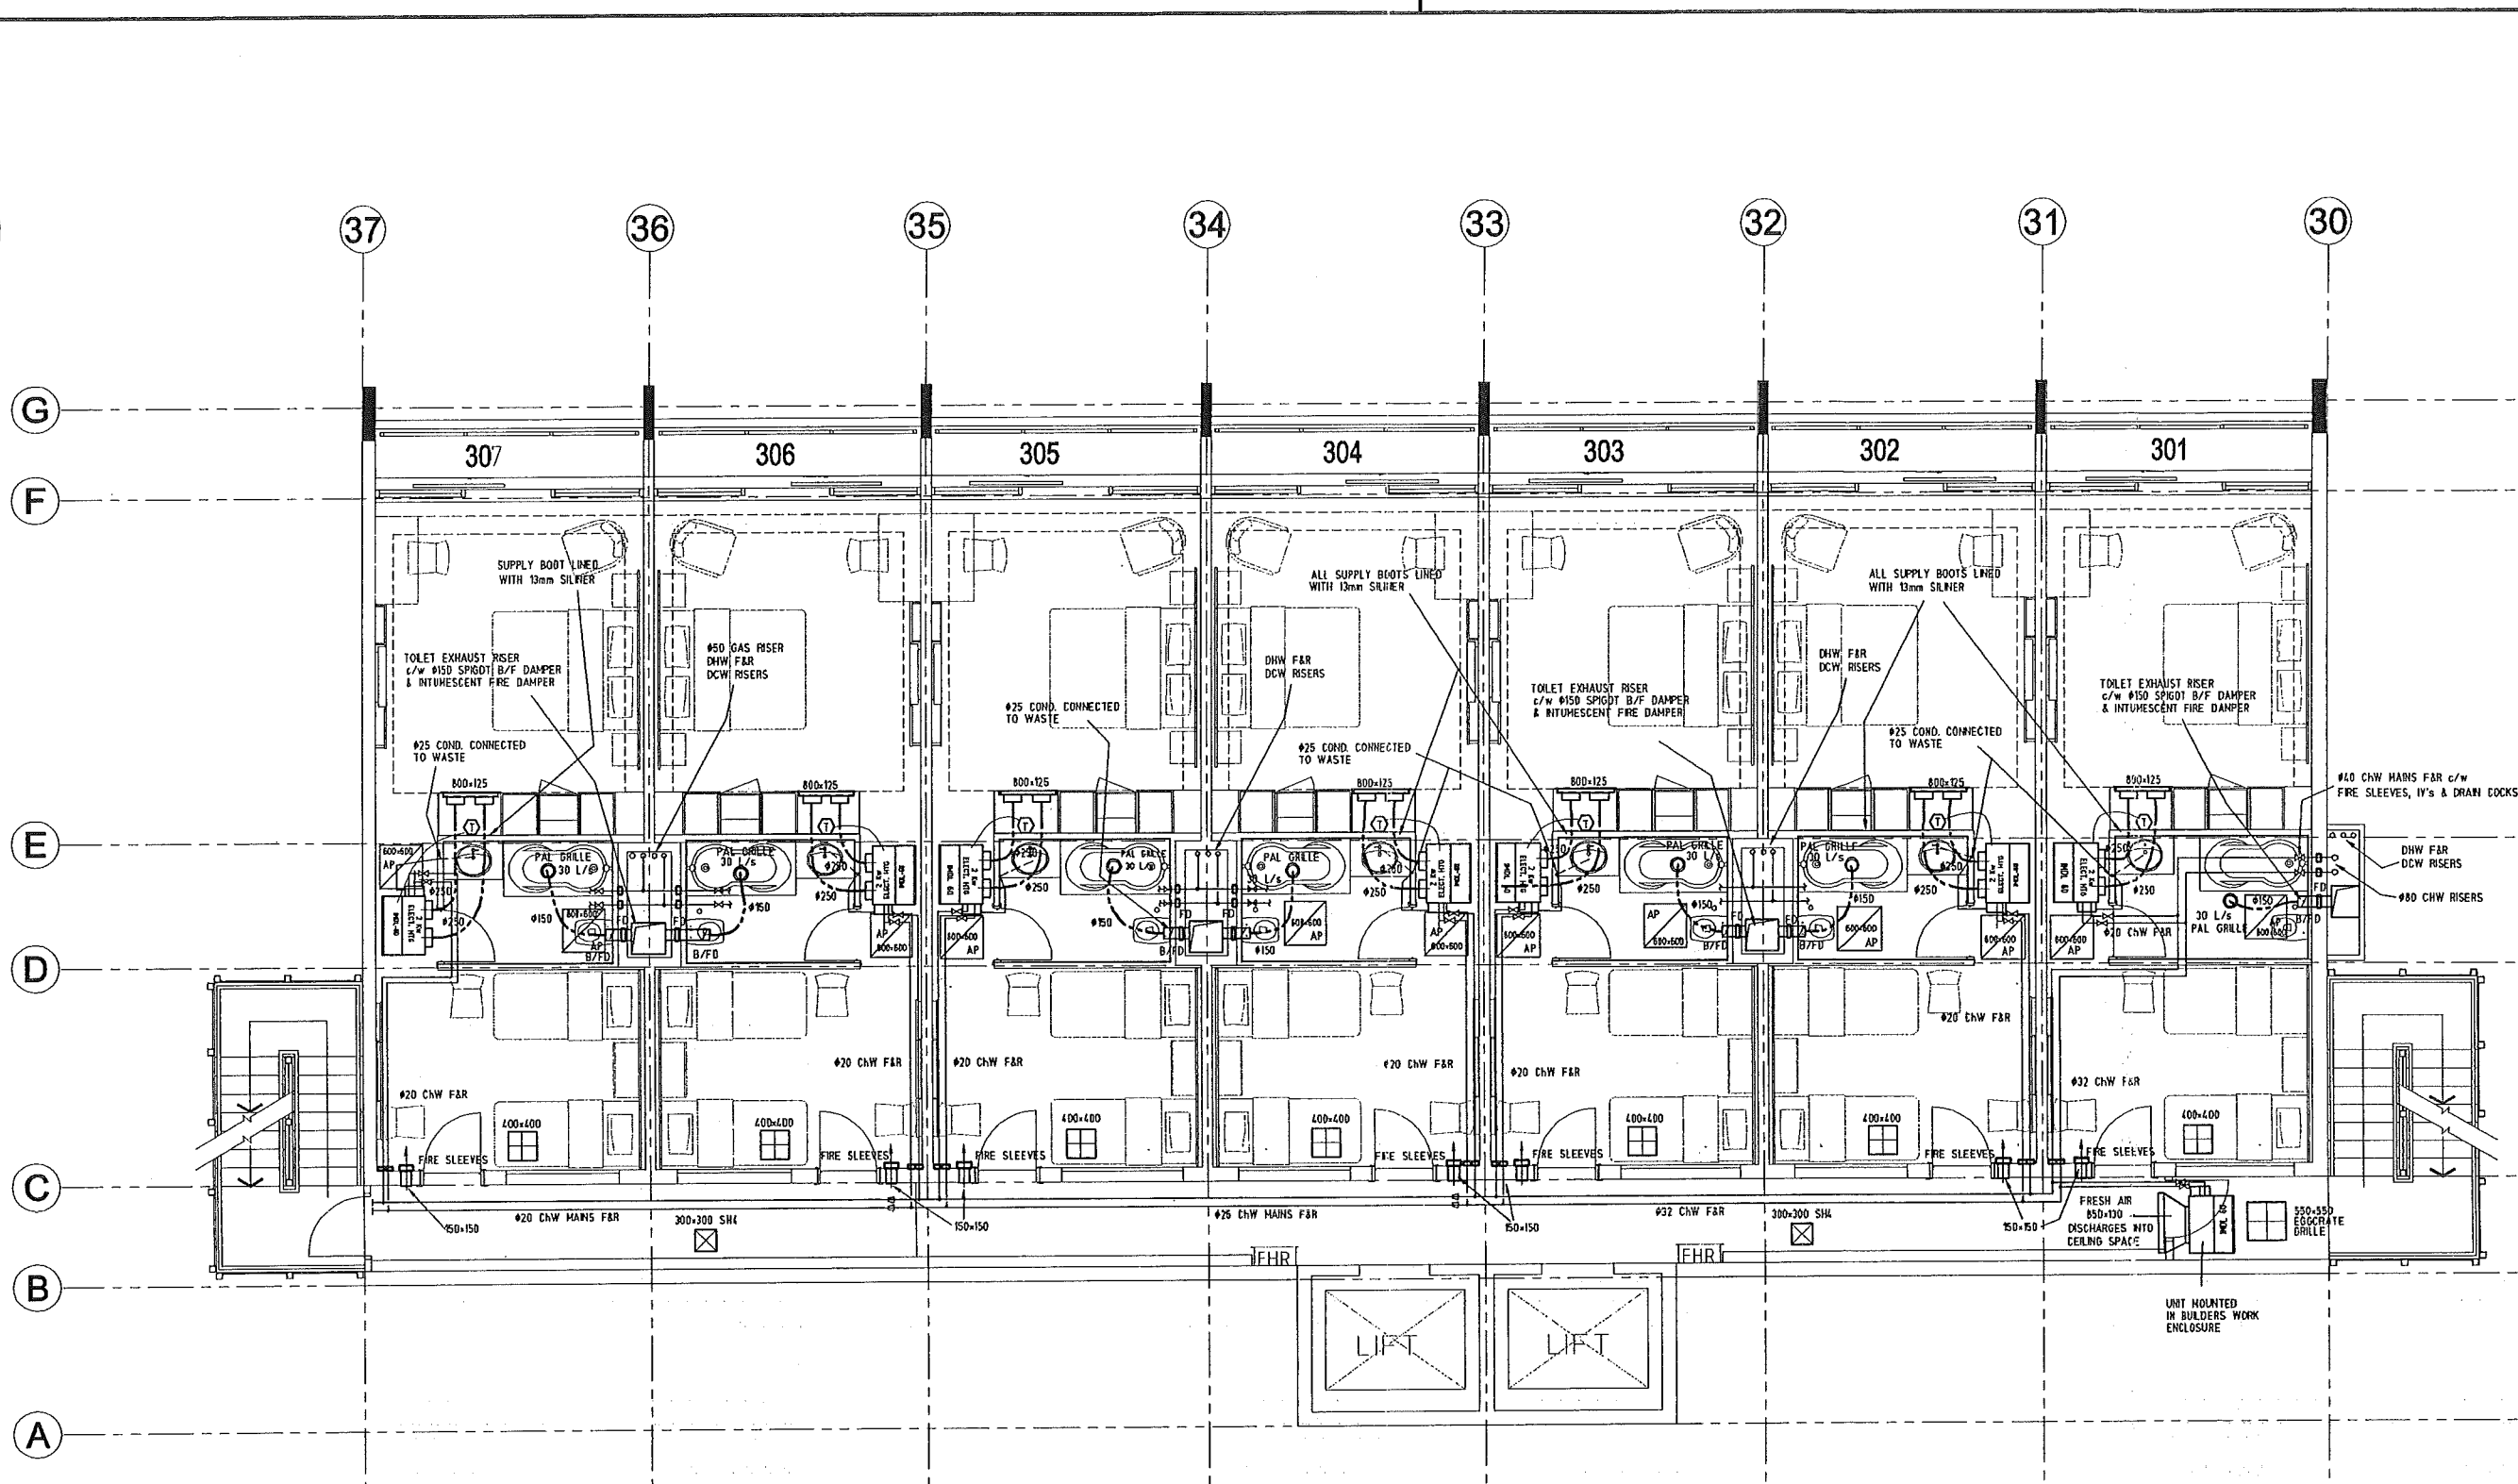

Wellington City Council
21 April 2021

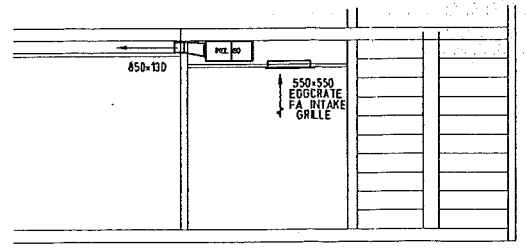

SECTION SHOWING FRESH AIR UNIT ENCLOSURE

Issue	Amendments	Date	Sign

AS BUILT DRAWING
DECEMBER 2007
THIS DRAWING IS A TRUE AND ACCURATE RECORD OF THE AS INSTALLED MECHANICAL SERVICES SYSTEM
Signed: WH

Stamp: **AS BUILT DRAWING**

Status of Drawing:	Authorized Sign:	Date
PRELIMINARY -		
FOR APPROVAL -		
FOR CONSTRUCTION -		

COPYRIGHT
The Document and the Copyright in this Document remain the Property of Economech Services Ltd. The Contents of this Document may not be reproduced without in whole or in part, by any means whatsoever without the prior written consent of Economech Services Ltd.


ECONOMECH SERVICES LTD
P.O. BOX 14048 PAINHUR, AUCKLAND, NZ
Ph: (09) 579-1444 Fax: (09) 579-2308
Email: alrecon@economech.co.nz

AIR CONDITIONING, REFRIGERATION & HEATING ENGINEERS

Project Title:
**KINGSGATE
ORIENTAL BAY
WELLINGTON**


Sheet Title:
**MECHANICAL SERVICES
BAY WING
LEVEL 3**

Drawn: RC	Code File: 1404-B3.dwg
Date: OCT'07	Scale at A1: 1:25 Scale at A3: 1:50
Drawing No: 1404-B3	Rev: -

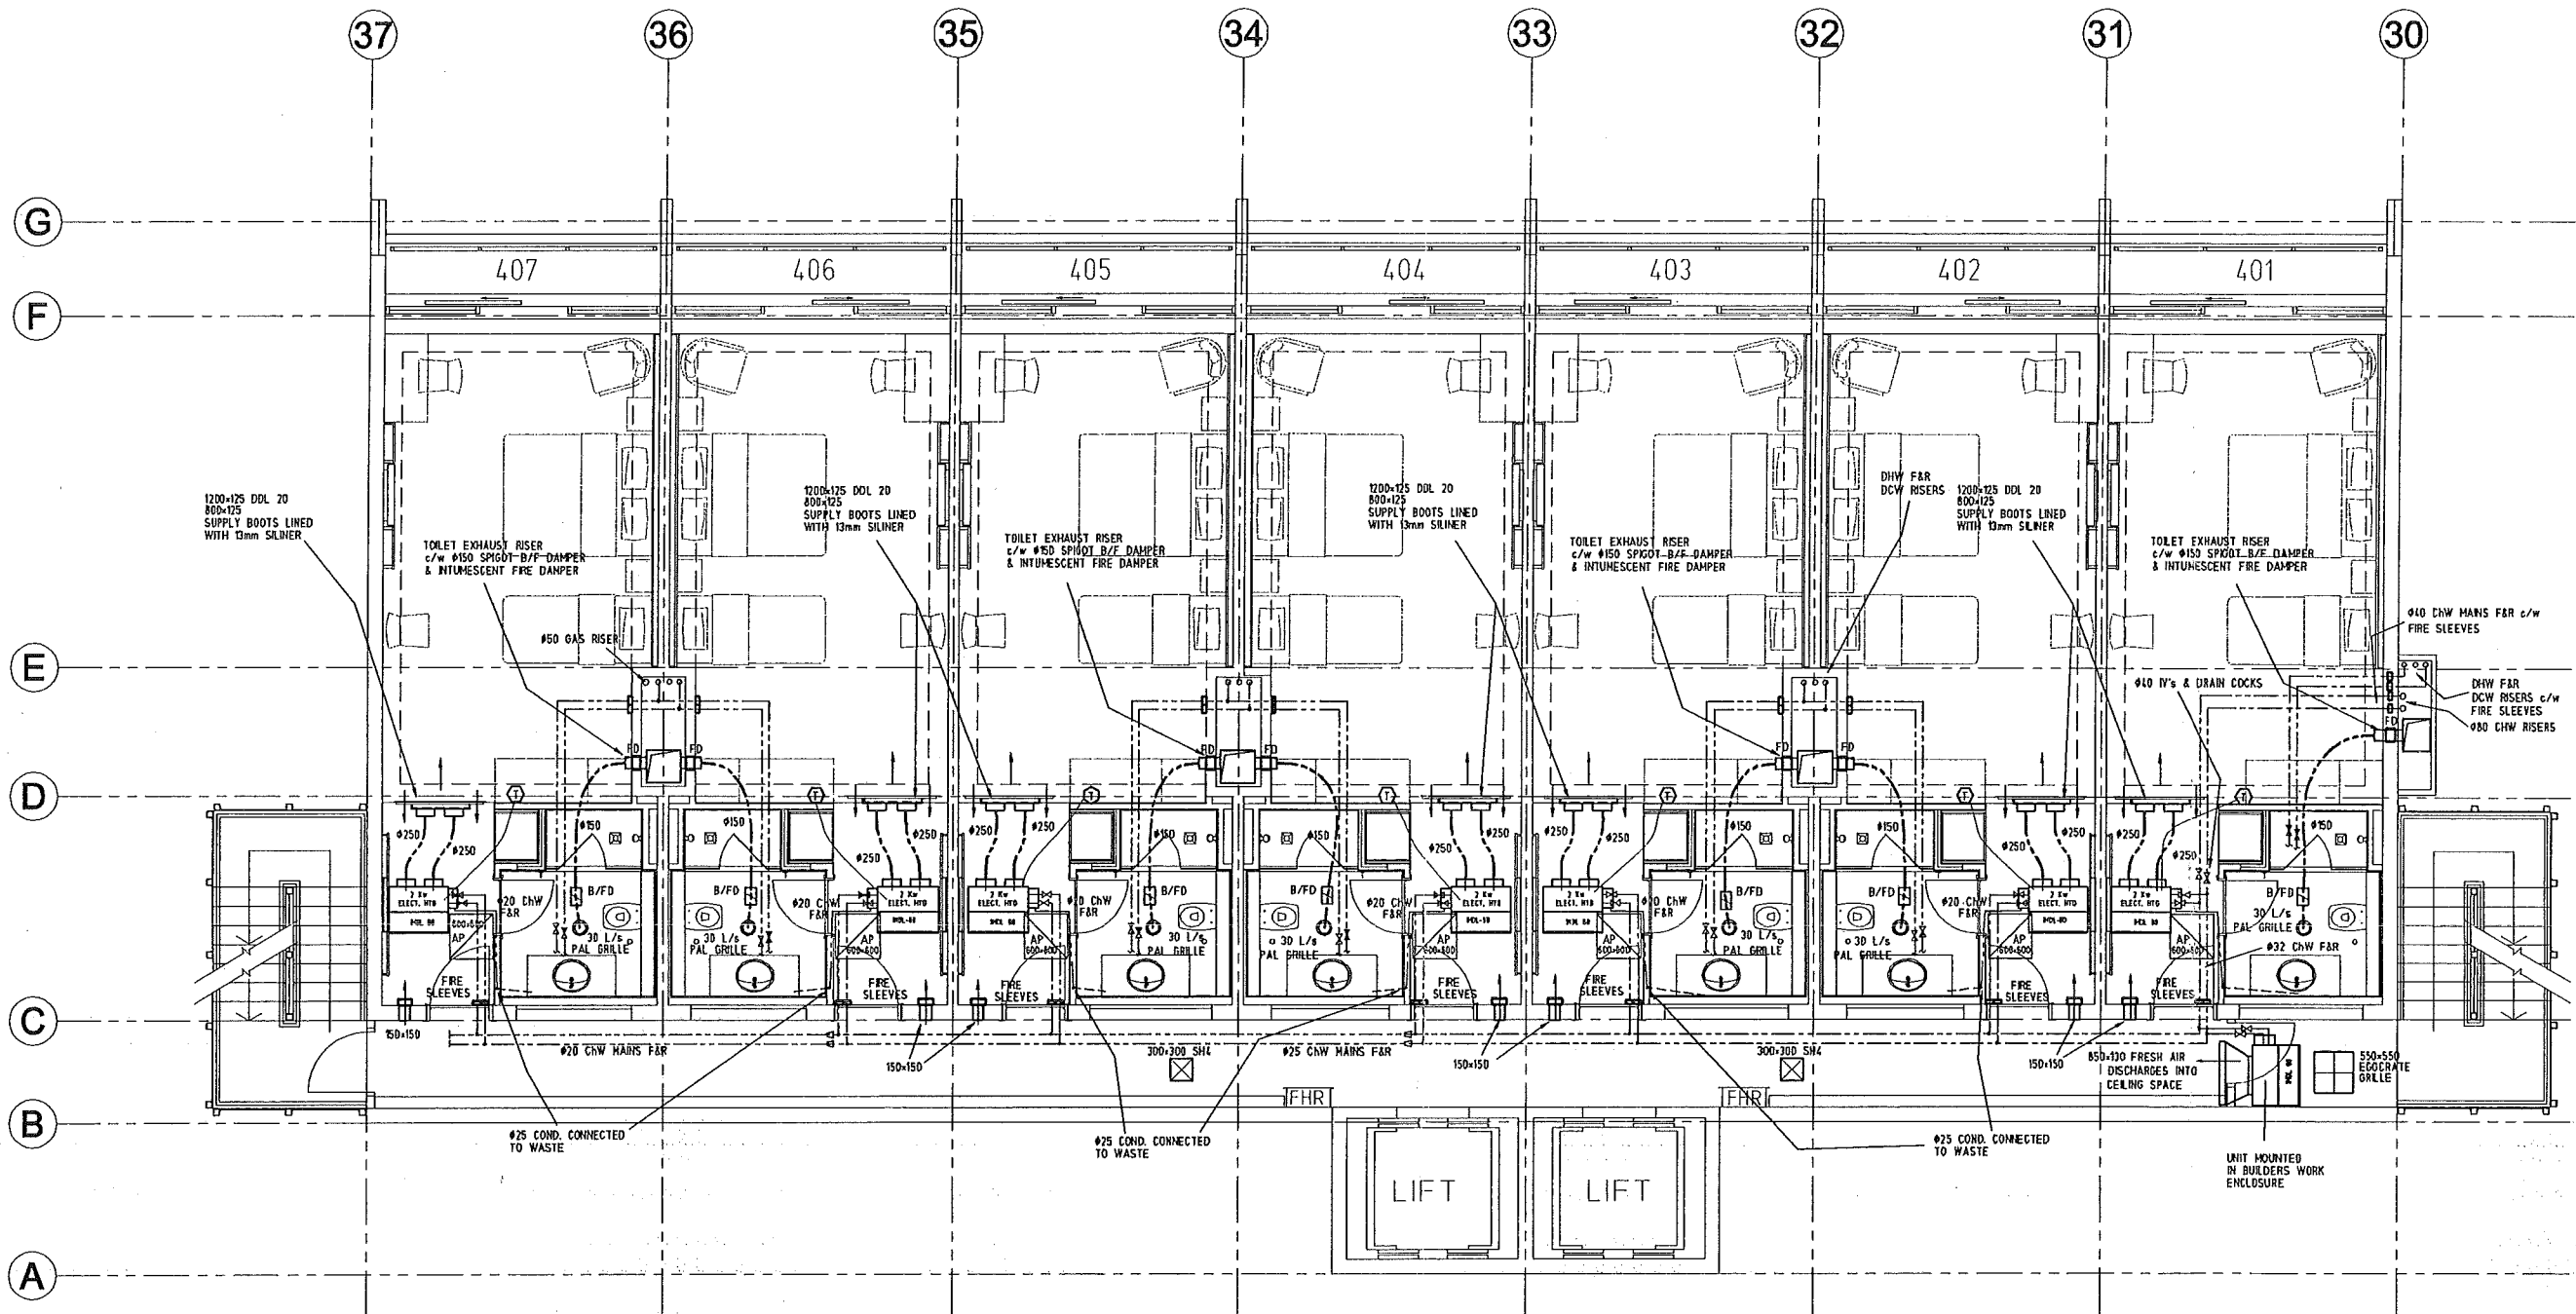


Wellington City Council
21 April 2021


Issue:	Amendments:	Date:	Sign:
AS BUILT DRAWING DECEMBER 2007 <small>THIS DRAWING IS A TRUE AND ACCURATE RECORD OF THE AS INSTALLED MECHANICAL SERVICES SYSTEM</small> Signed: _____ WH			
AS BUILT DRAWING			
Status of Drawing:	Authorized Sign:	Date:	
PRELIMINARY -			
FOR APPROVAL -			
FOR CONSTRUCTION -			
<small>COPYRIGHT This Document and the Copyright in this Document remain the Property of Economech Services Ltd. The Contents of this Document may not be Reproduced either in whole or in part, by any means whatsoever without the prior written consent of Economech Services Ltd.</small>			
ECONOMECH SERVICES LTD <small>P.O. BOX 14018 PANHURE, AUCKLAND, NZ Ph: (09) 579-1444 Fax: (09) 579-2308 Email: alican@economech.co.nz</small>			
AIR CONDITIONING, REFRIGERATION & HEATING ENGINEERS			
Project Title:			
KINGSGATE ORIENTAL BAY WELLINGTON			
Sheet Title:			
MECHANICAL SERVICES BAY WING LEVEL 4			
Drawn:	RC	Code:	1404-4.dwg
Date:	OCT'07	Scale at A1:	1:25
		Scale at A3:	1:50
Drawing No:	1404-B4		

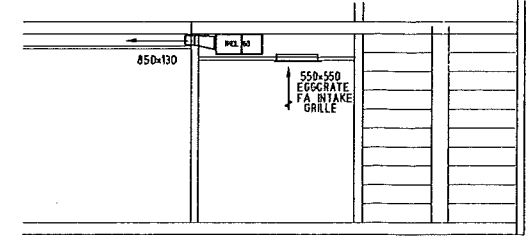

SECTION SHOWING FRESH AIR UNIT ENCLOSURE

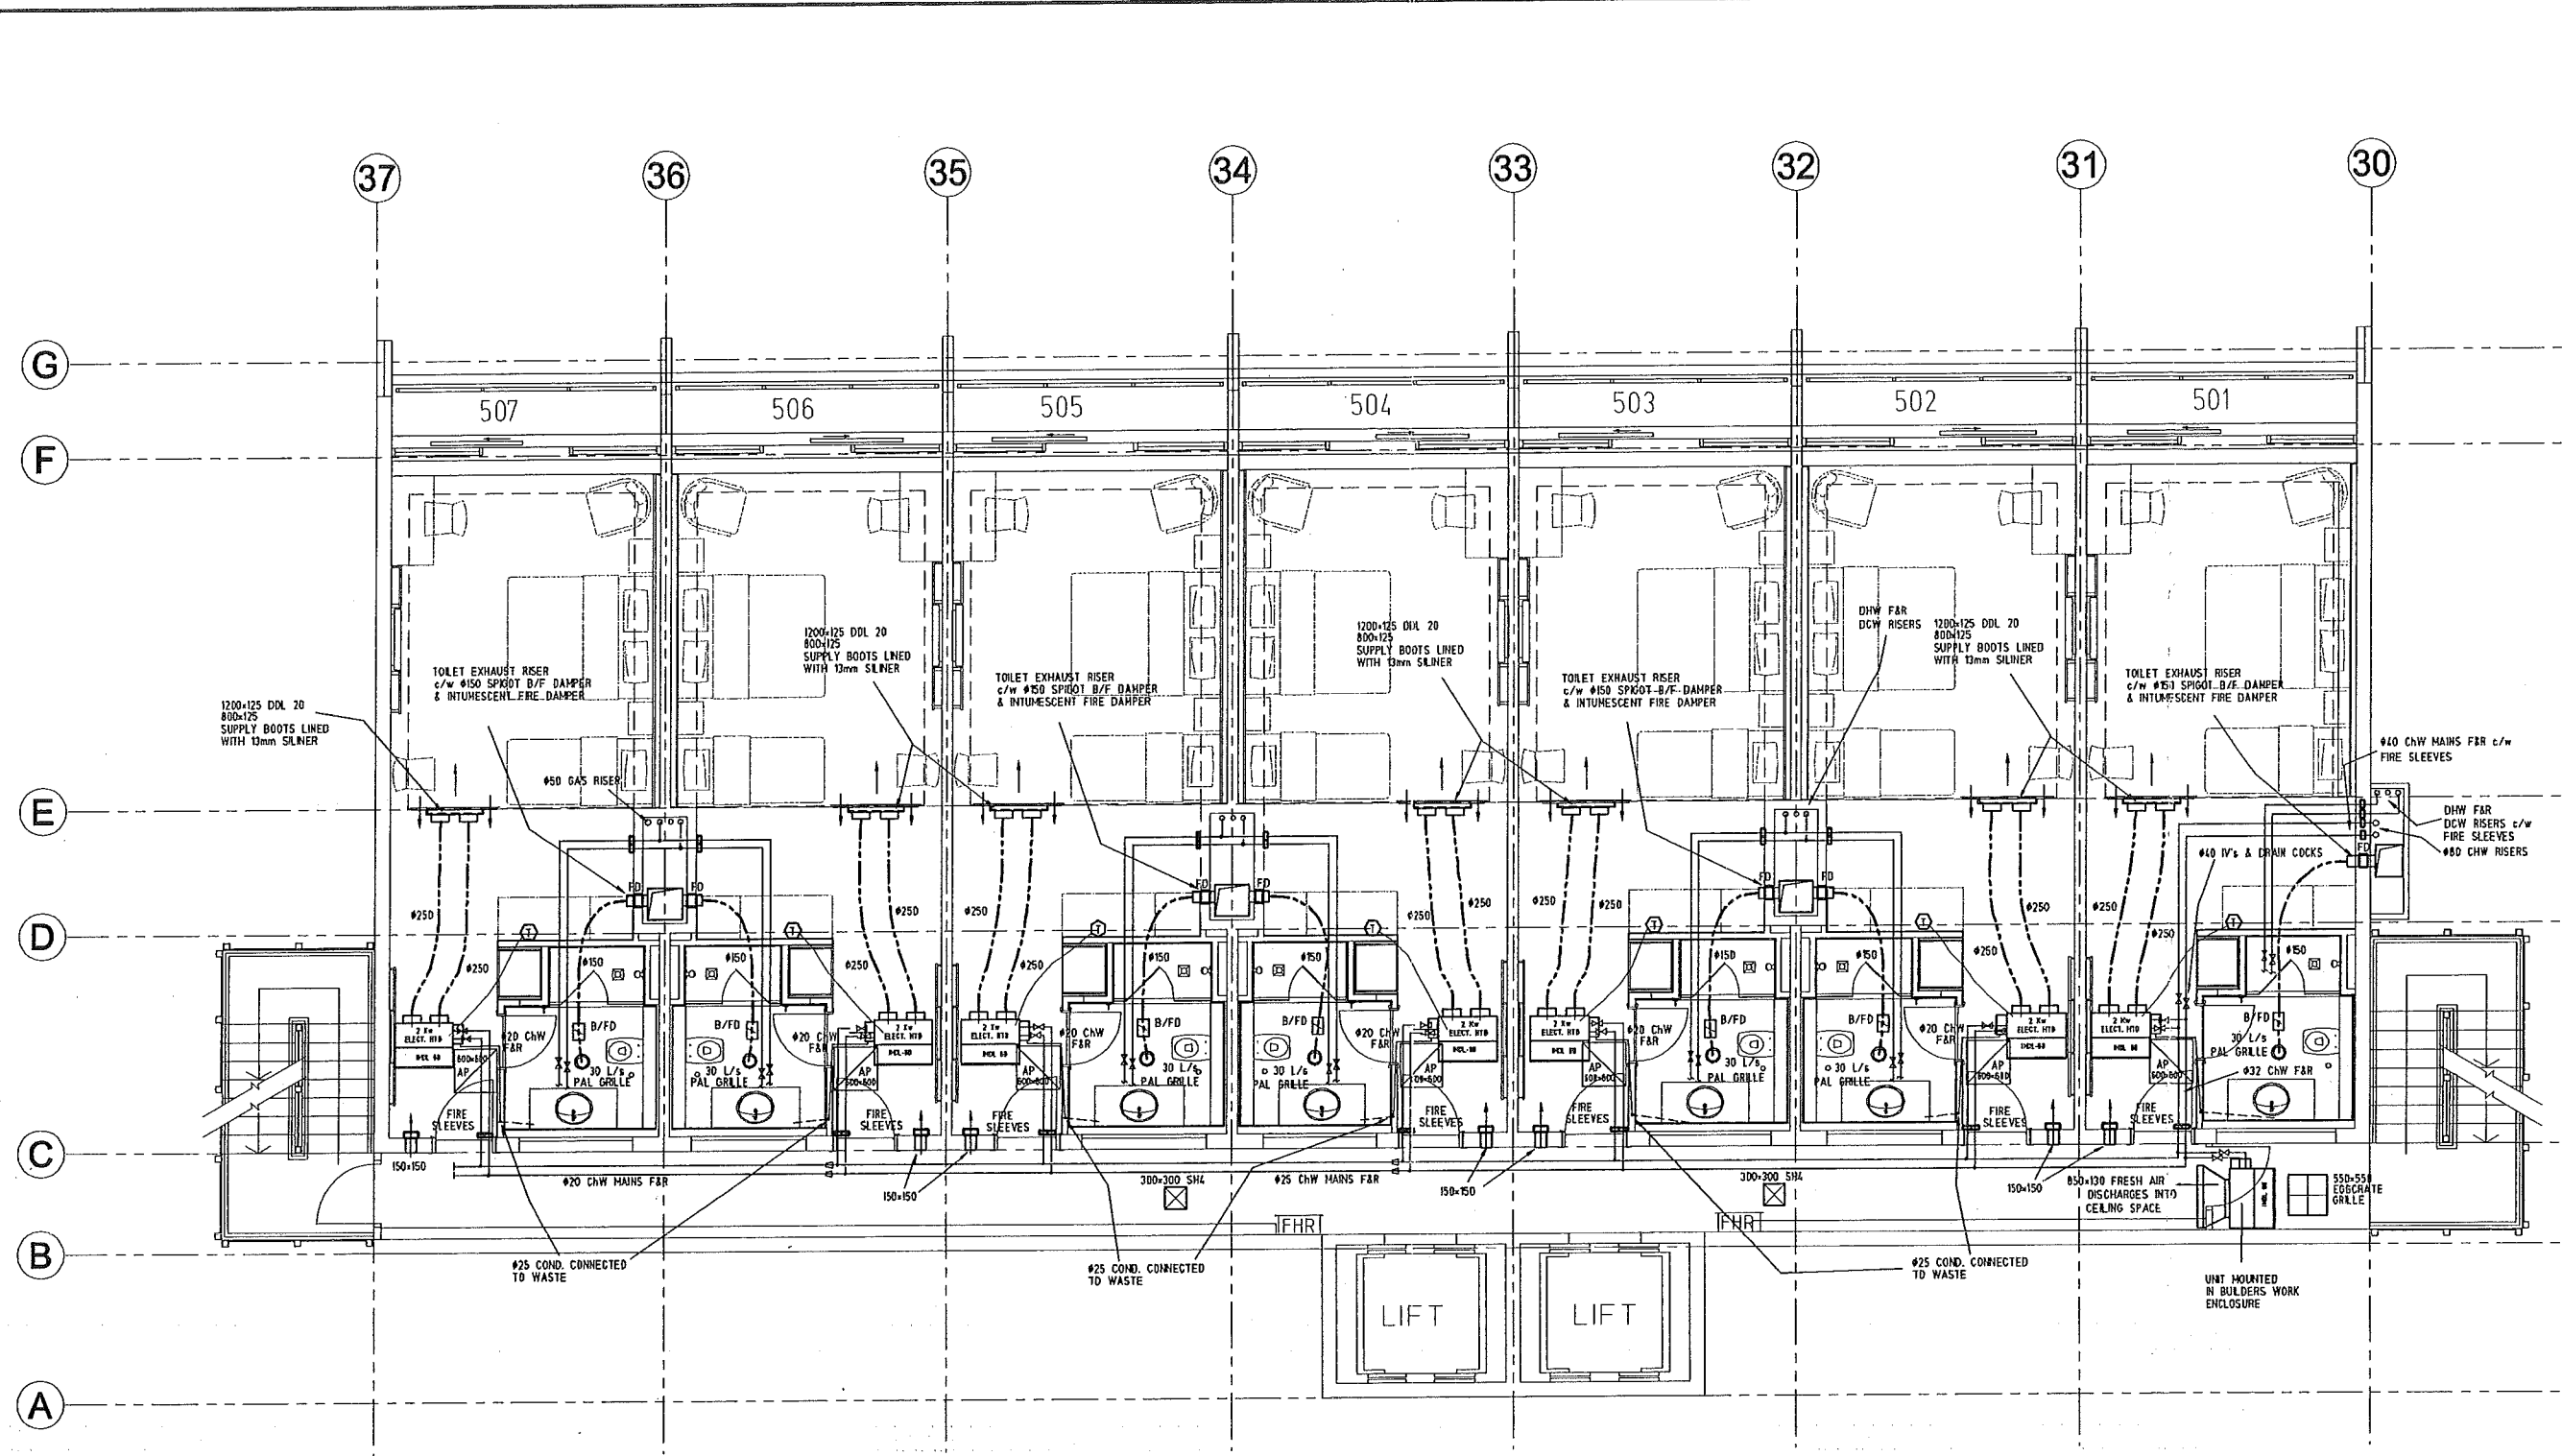

Wellington City Council
21 April 2021

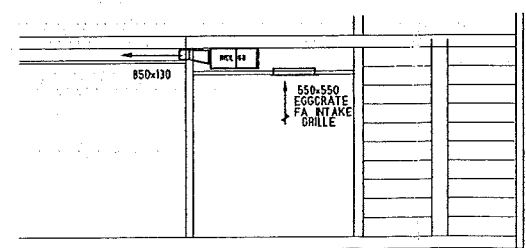

SECTION SHOWING FRESH AIR UNIT ENCLOSURE

Issue	Amendments	Date	Sign

AS BUILT DRAWING
DECEMBER 2007
THIS DRAWING IS A TRUE AND ACCURATE
RECORD OF THE AS INSTALLED MECHANICAL
SERVICES SYSTEM
Signed: WH

Stamp:
AS BUILT DRAWING

Status of Drawing	Authorized Sign	Date
PRELIMINARY -		
FOR APPROVAL -		
FOR CONSTRUCTION -		

COPYRIGHT
This Document and the Copyright in this Document remain the
Property of Economech Services Ltd. The Contents of this
Document may not be reproduced, stored in a retrieval system,
or transmitted in any form or by any means, electronic, mechanical,
photocopying, recording, or by any information storage and retrieval
system, without the prior written consent of
Economech Services Ltd.



ECONOMECH SERVICES LTD
P.O. BOX 1418 PAHAURE, AUCKLAND, NZ
Ph: (09) 579-1414 Fax: (09) 579-2398
Email: aircan@economech.co.nz

**AIR CONDITIONING, REFRIGERATION
& HEATING ENGINEERS**

Project Title:
**KINGSGATE
ORIENTAL BAY
WELLINGTON**

Sheet Title:
**MECHANICAL SERVICES
BAY WING
LEVEL 5**


Drawn: RC	Proj No: 1404-B5.dwg
Date: OCT'07	Scale at A1: 1:25 Scale at A3: 1:50
Drawing No: 1404-B5	Rev: -

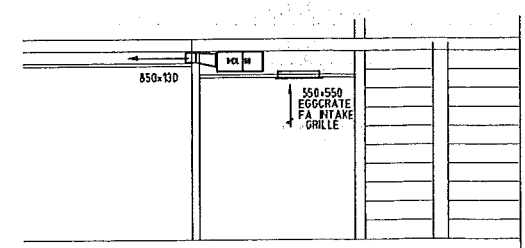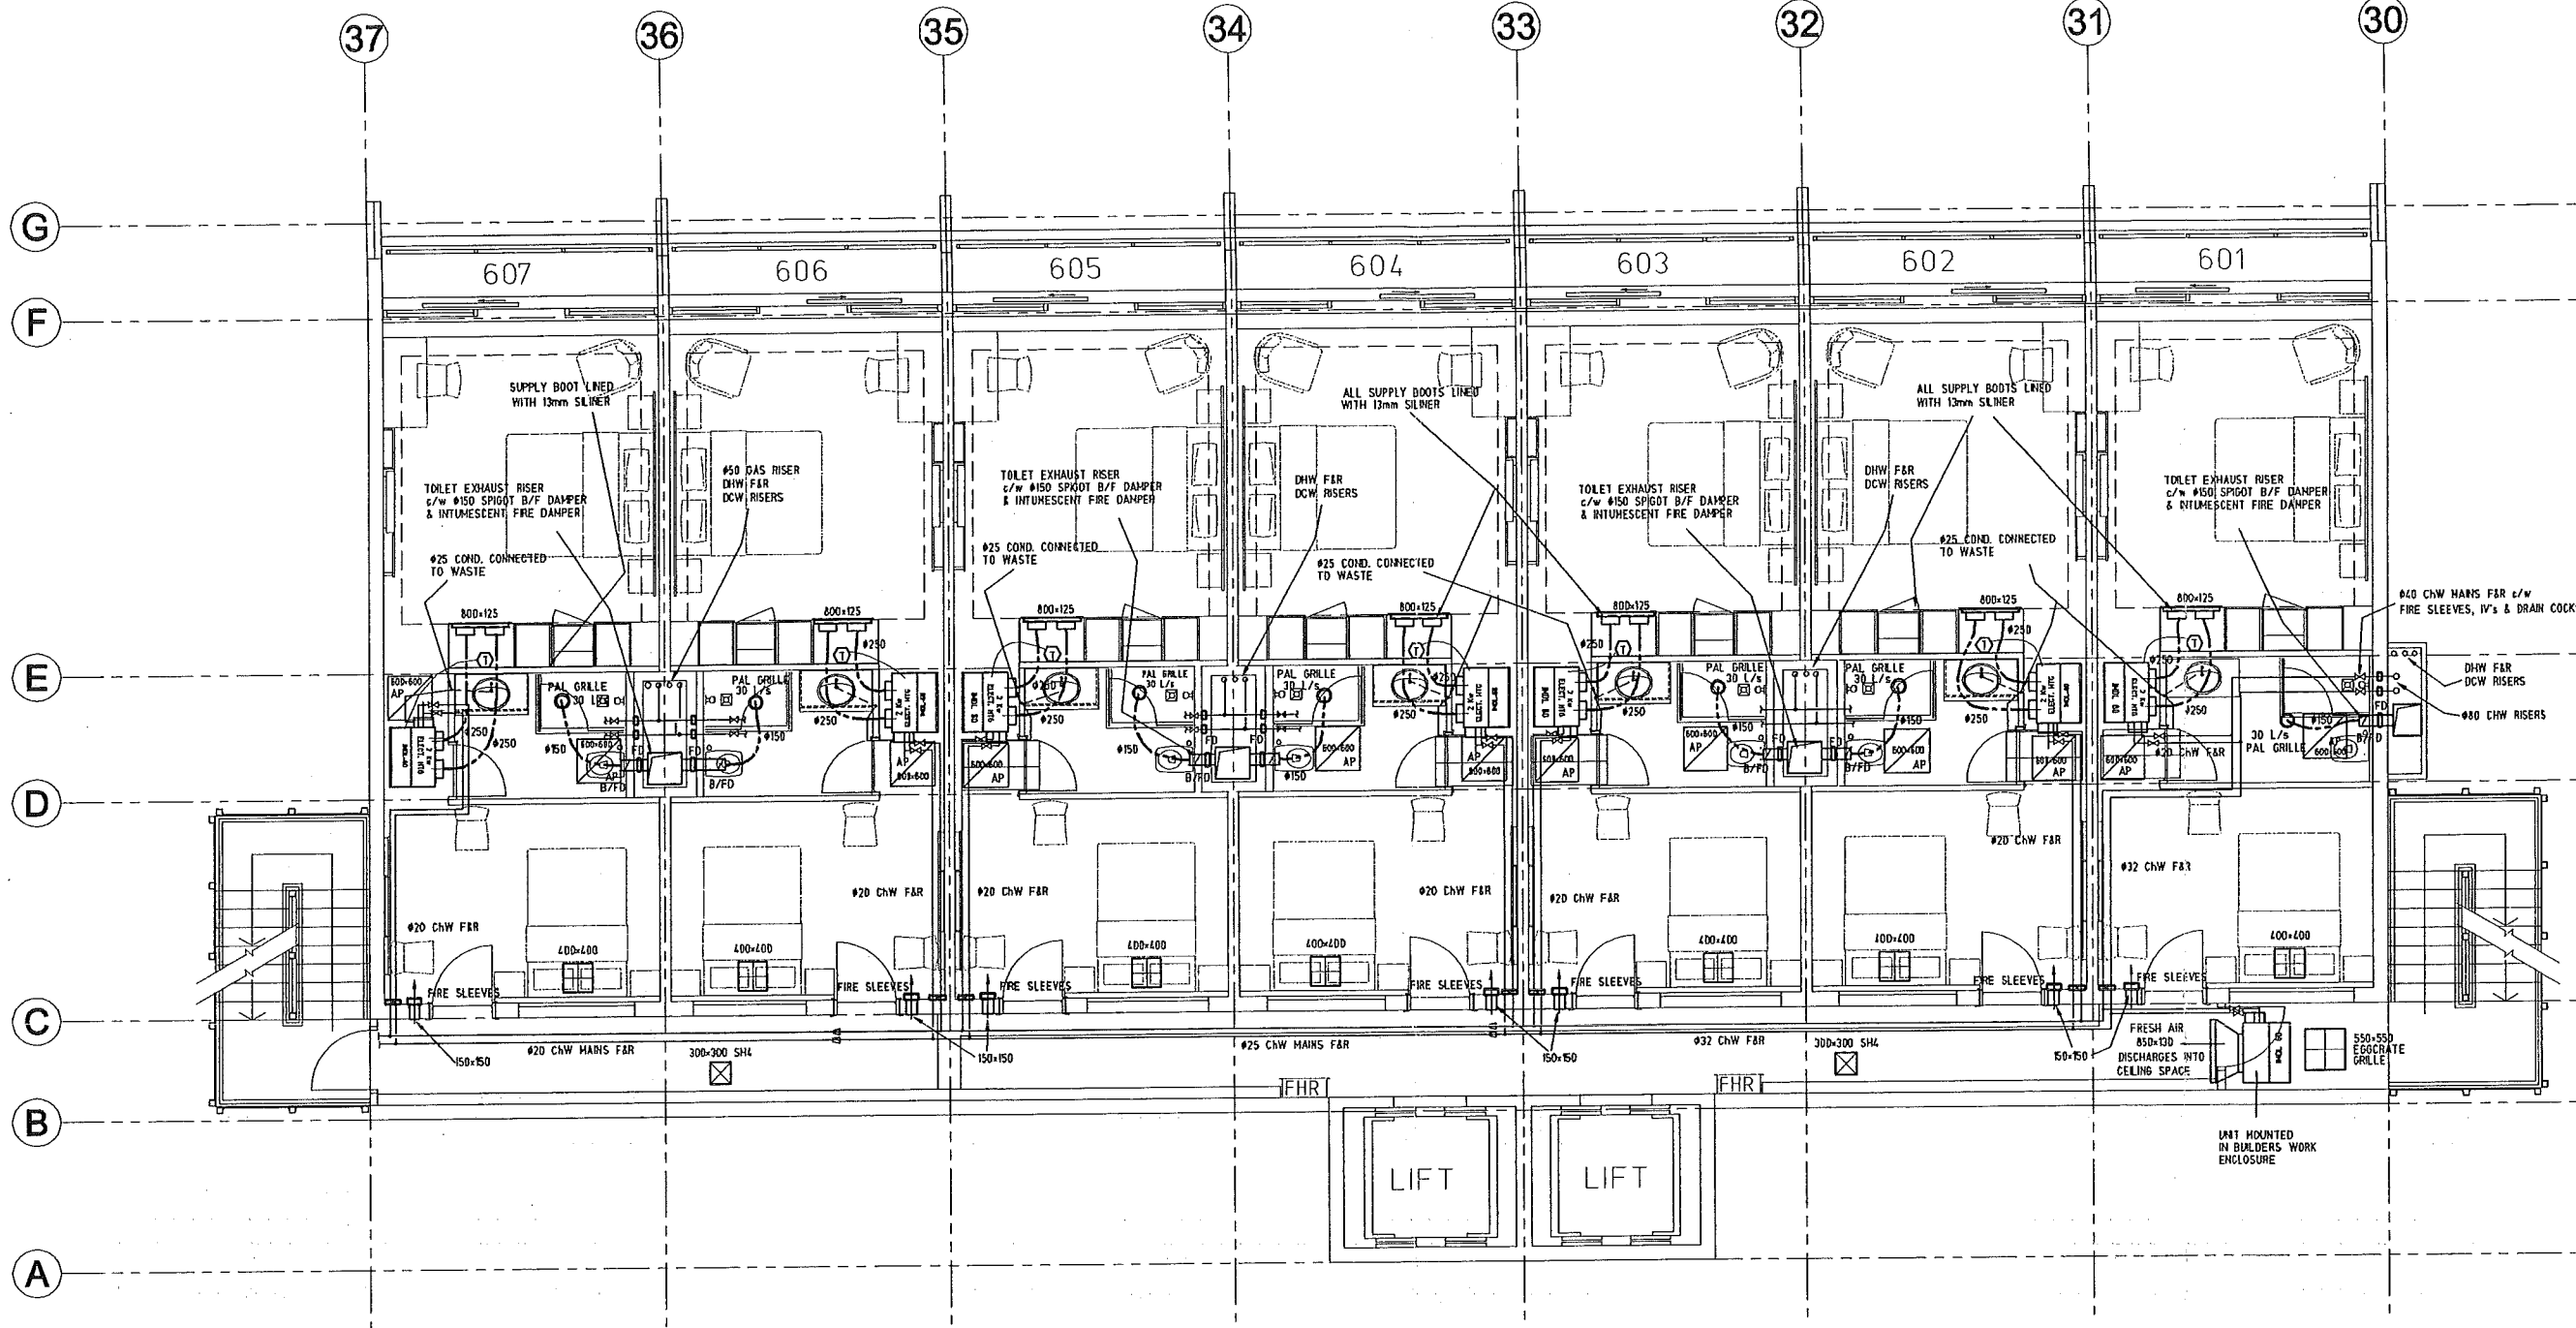

SECTION SHOWING FRESH AIR UNIT ENCLOSURE

Wellington City Council
21 April 2021

Issue:	Amendments:	Date:	Sign:
AS BUILT DRAWING DECEMBER 2007 THIS DRAWING IS A TRUE AND ACCURATE RECORD OF THE AS INSTALLED MECHANICAL SERVICES SYSTEM Signed: <u>WH</u>			
Stamp: AS BUILT DRAWING			
Status of Drawing:	Authorized Sign:	Date:	
PRELIMINARY -			
FOR APPROVAL -			
FOR CONSTRUCTION -			
COPYRIGHT © <small>This Document and the Copyright in this Document remain the Property of Economech Services Ltd. The Contents of this Document may not be reproduced either in whole or in part, by any means whatsoever without the prior written consent of Economech Services Ltd.</small>			
ECONOMECH SERVICES LTD P.O. BOX 1428 PANHURU, AUCKLAND, NZ Ph: (09) 578-1444 Fax: (09) 578-2308 Email: alcon@economech.co.nz			
AIR CONDITIONING, REFRIGERATION & HEATING ENGINEERS			
Project Title: KINGSGATE ORIENTAL BAY WELLINGTON			
Sheet Title: MECHANICAL SERVICES BAY WING LEVEL 6			
Drawn: RC	Cad File: 1404-B.dwg		
Date: OCT'07	Scale at A1: 1:25		Rev: -
Drawing No: 1404-B6			

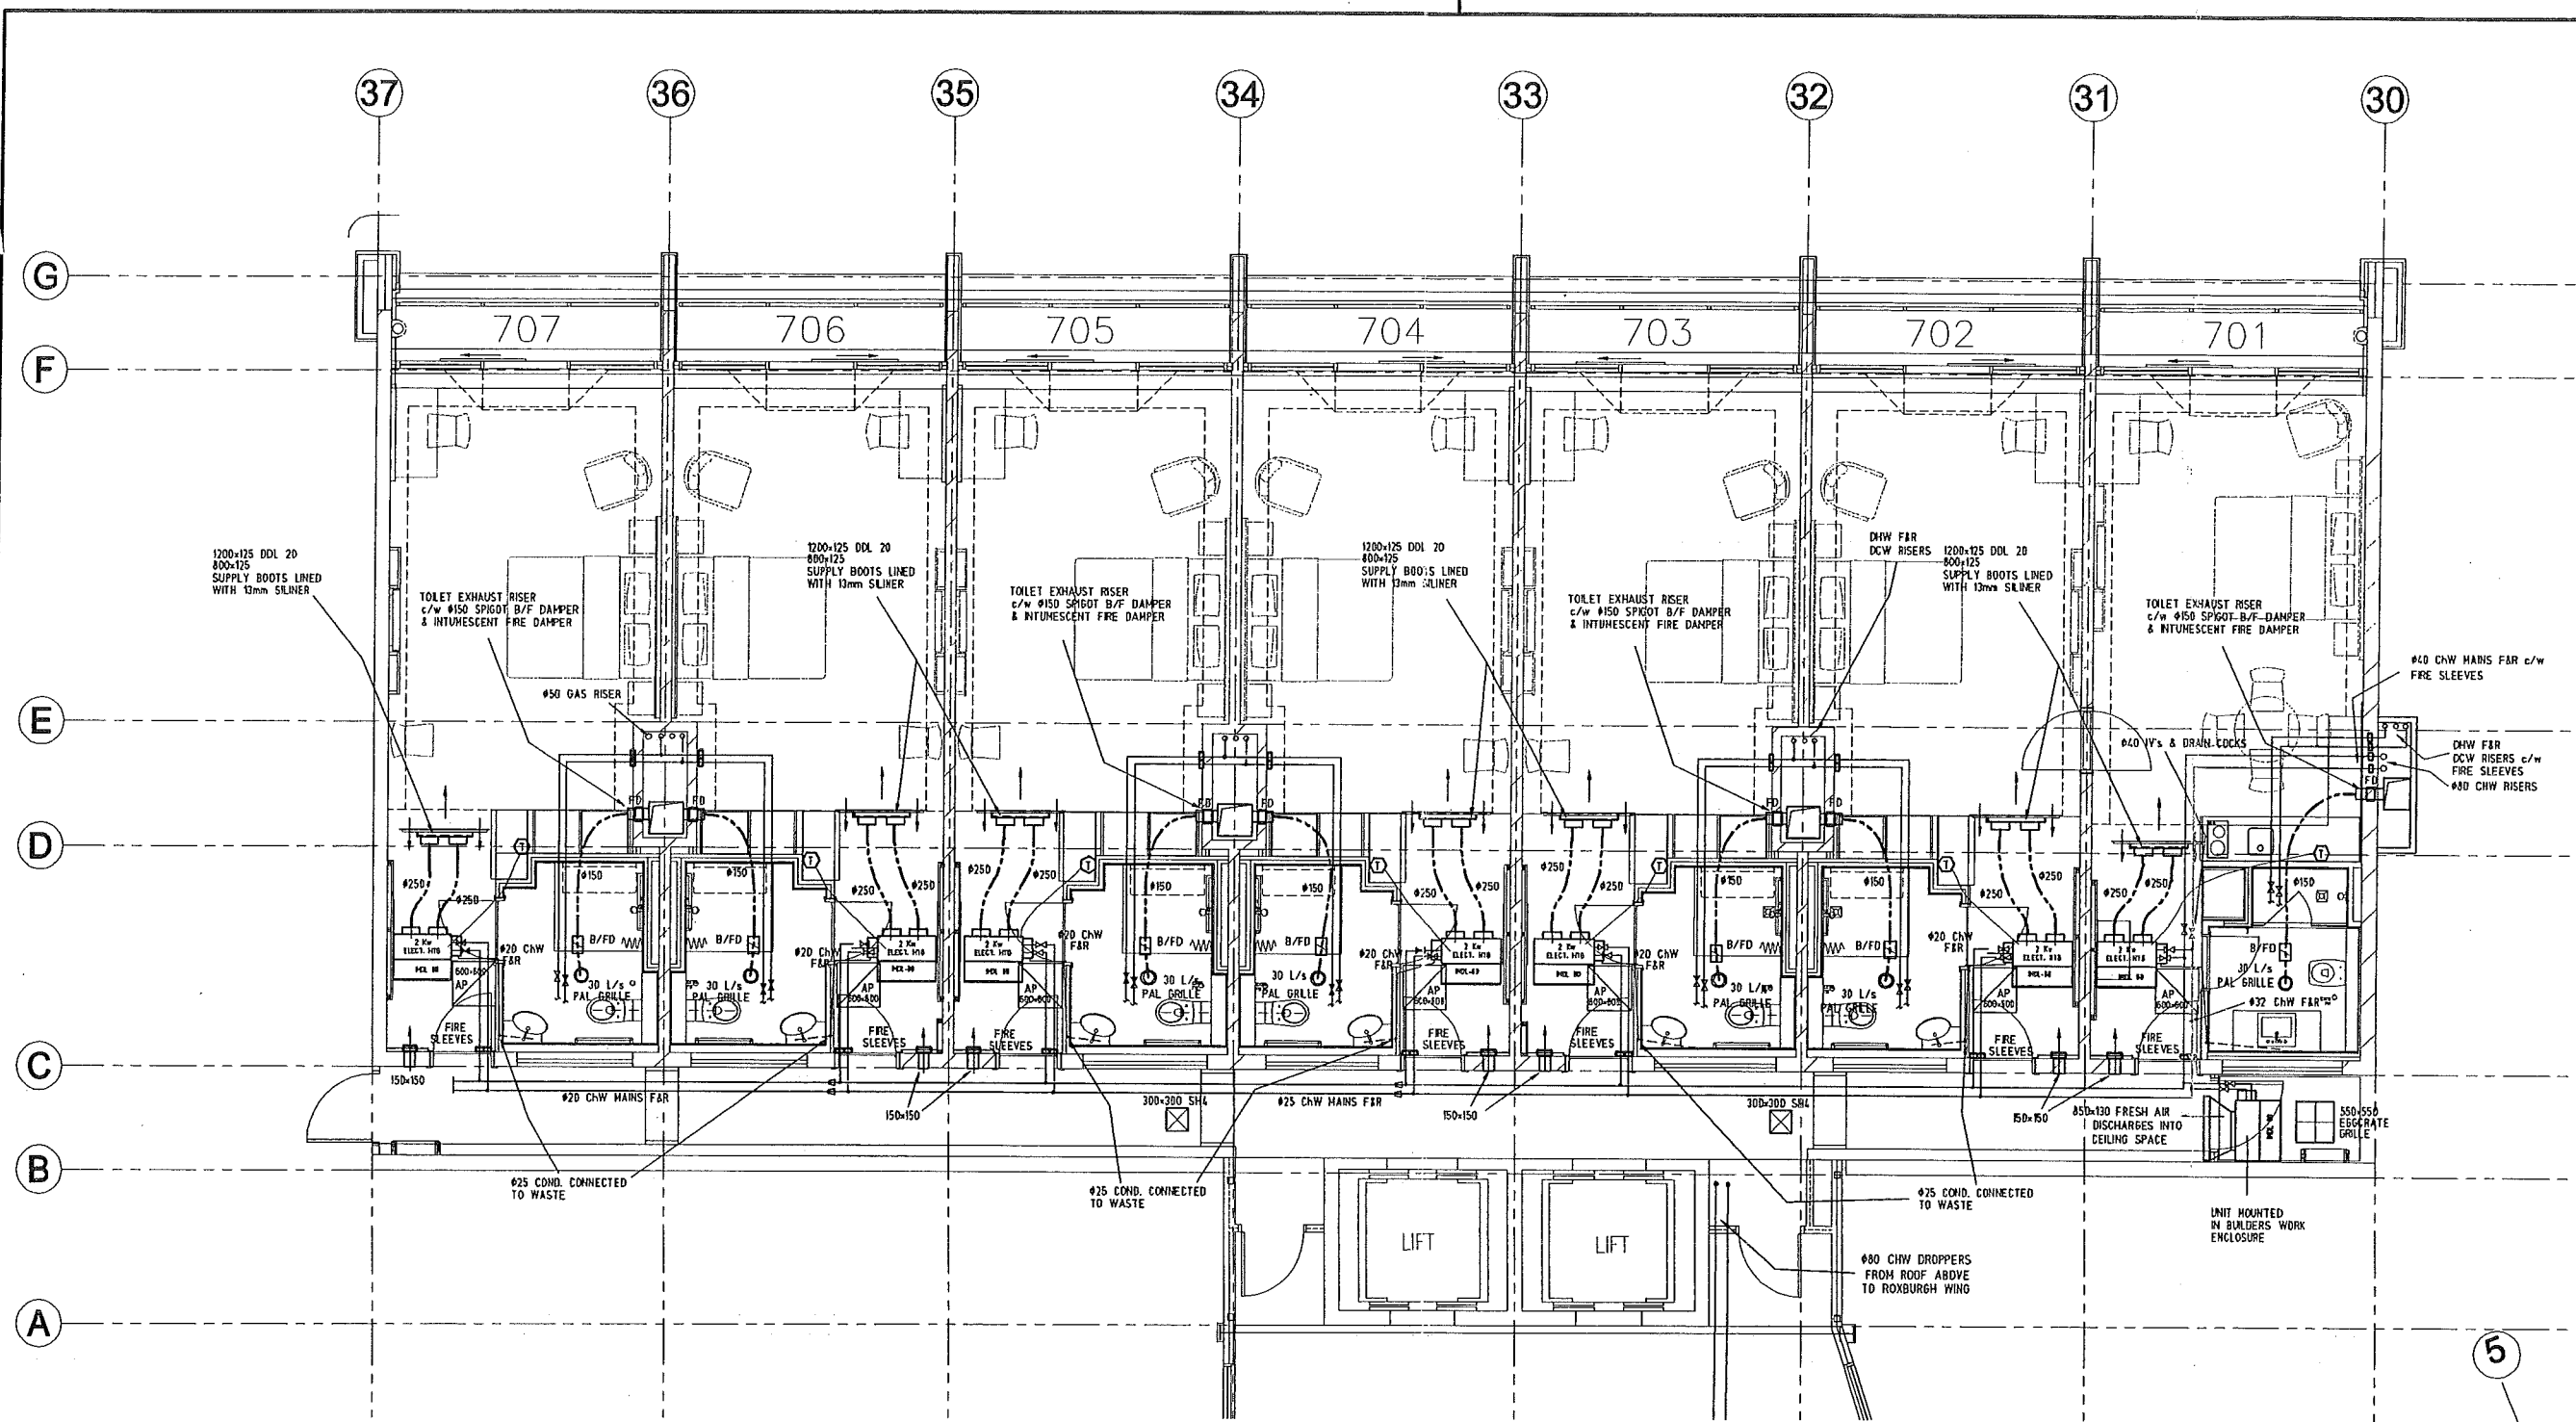

Issue:	Amendments	Date:	Spn:

AS BUILT DRAWING
DECEMBER 2007
 THIS DRAWING IS A TRUE AND ACCURATE RECORD OF THE AS INSTALLED MECHANICAL SERVICES SYSTEM
 Signed: WH

Stamp:

AS BUILT DRAWING

Status of Drawing:	Authorised Sign:	Date:
PRELIMINARY -		
FOR APPROVAL -		
FOR CONSTRUCTION -		

COPYRIGHT
 This Document and the Copyright in this Document remain the Property of Economech Services Ltd. The Contents of this Document may not be reproduced without the prior written consent of Economech Services Ltd.


ECONOMECH SERVICES LTD
 P.O. BOX 1404 PANHURE, AUCKLAND, NZ
 Ph: (09) 579-1444 Fax: (09) 579-2305
 Email: ascon@economech.co.nz
AIR CONDITIONING, REFRIGERATION & HEATING ENGINEERS

Project Title:
KINGSGATE ORIENTAL BAY WELLINGTON


Sheet Title:
MECHANICAL SERVICES BAY WING LEVEL 7

Drawn: RC	Code File: 1404-7.dwg
Date: OCT'07	Scale at A1: 1:25 Scale at A3: 1:50
Drawing No: 1404-B7	Rev: -

Wellington City Council
21 April 2021

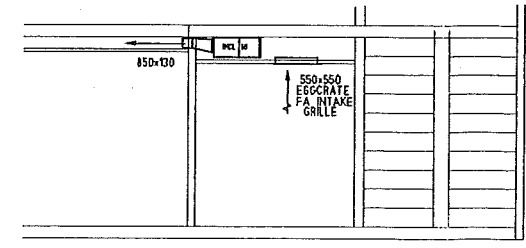

SECTION SHOWING FRESH AIR UNIT ENCLOSURE

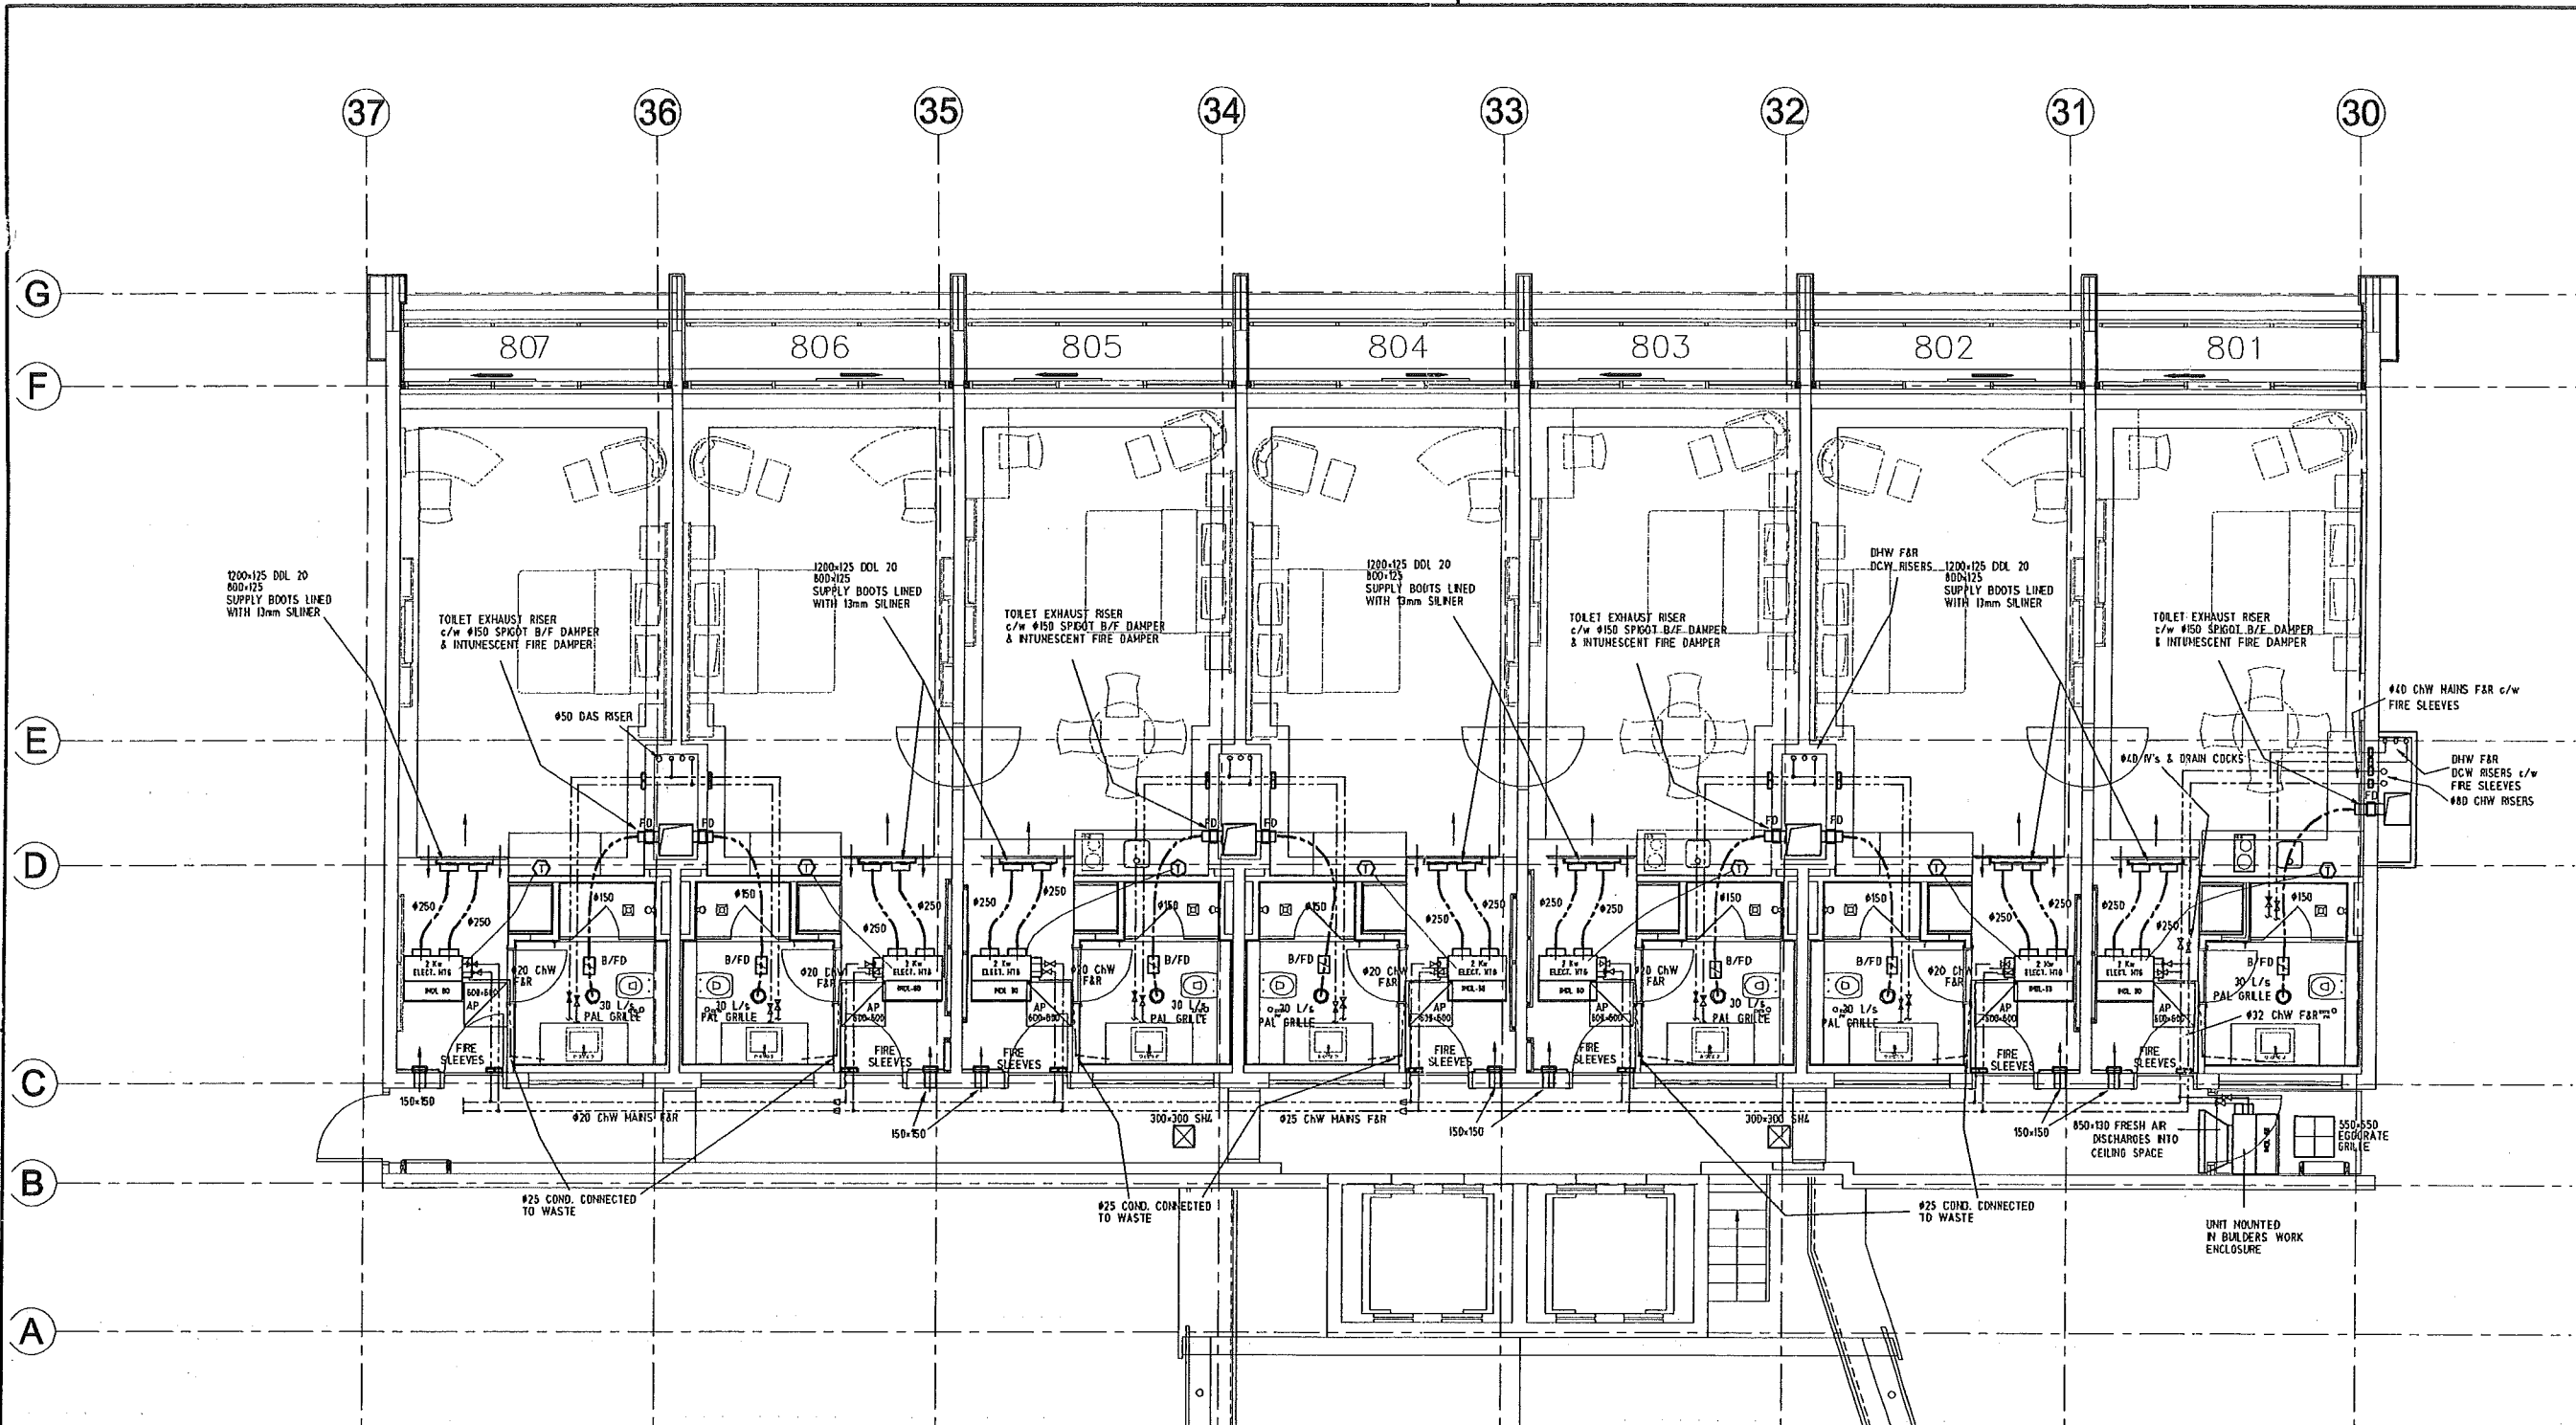

AS BUILT DRAWING
 DECEMBER 2007
 THIS DRAWING IS A TRUE AND ACCURATE
 RECORD OF THE AS INSTALLED MECHANICAL
 SERVICES SYSTEM
 Signed: WH

AS BUILT DRAWING		
Status of Drawing	Authorized Sign	Date
PRELIMINARY -		
FOR APPROVAL -		
FOR CONSTRUCTION -		

COPYRIGHT*
 This Document and the Copyright in this Document remain the
 Property of Economech Services Ltd. The Contents of the
 Document may not be reproduced either in whole or in part,
 by any means whatsoever without the prior written consent of
 Economech Services Ltd.


ECONOMECH SERVICES LTD
 P.O. BOX 1404 PANMURE, AUCKLAND, NZ
 Ph: (09) 579-1444 Fax: (09) 575-2308
 Email: aecon@economech.co.nz
 AIR CONDITIONING, REFRIGERATION
 & HEATING ENGINEERS

Project Title:
**KINGSGATE
 ORIENTAL BAY
 WELLINGTON**

Sheet Title:
**MECHANICAL SERVICES
 BAY WING
 LEVEL 8**

Drawn: RC	Cad File: 1404-B.dwg
Date: OCT'07	Scale at A1: 1:25 Scale at A3: 1:50
Drawing No: 1404-B8	Rev: -


Wellington City Council
21 April 2021

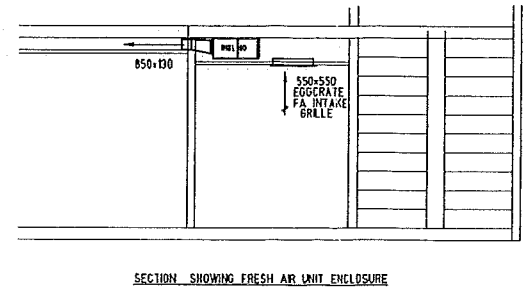

SECTION SHOWING FRESH AIR UNIT ENCLOSURE


Wellington City Council
21 April 2021

BLUE - UNDESIGNATED AREA
 PINK - SUPERVISED AREA

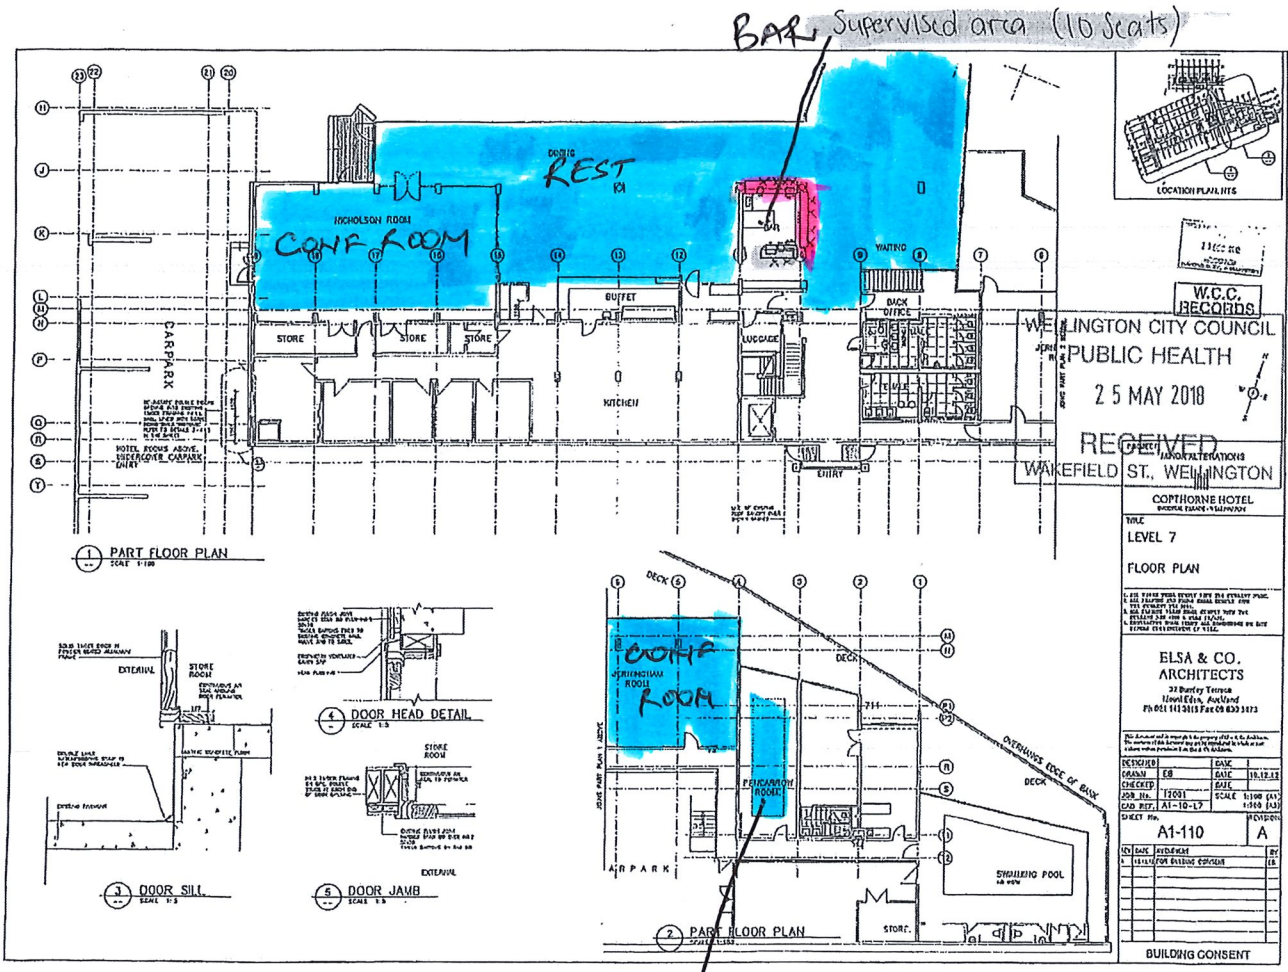


CONF ROOM

Rev	Amendment	Date	Sign

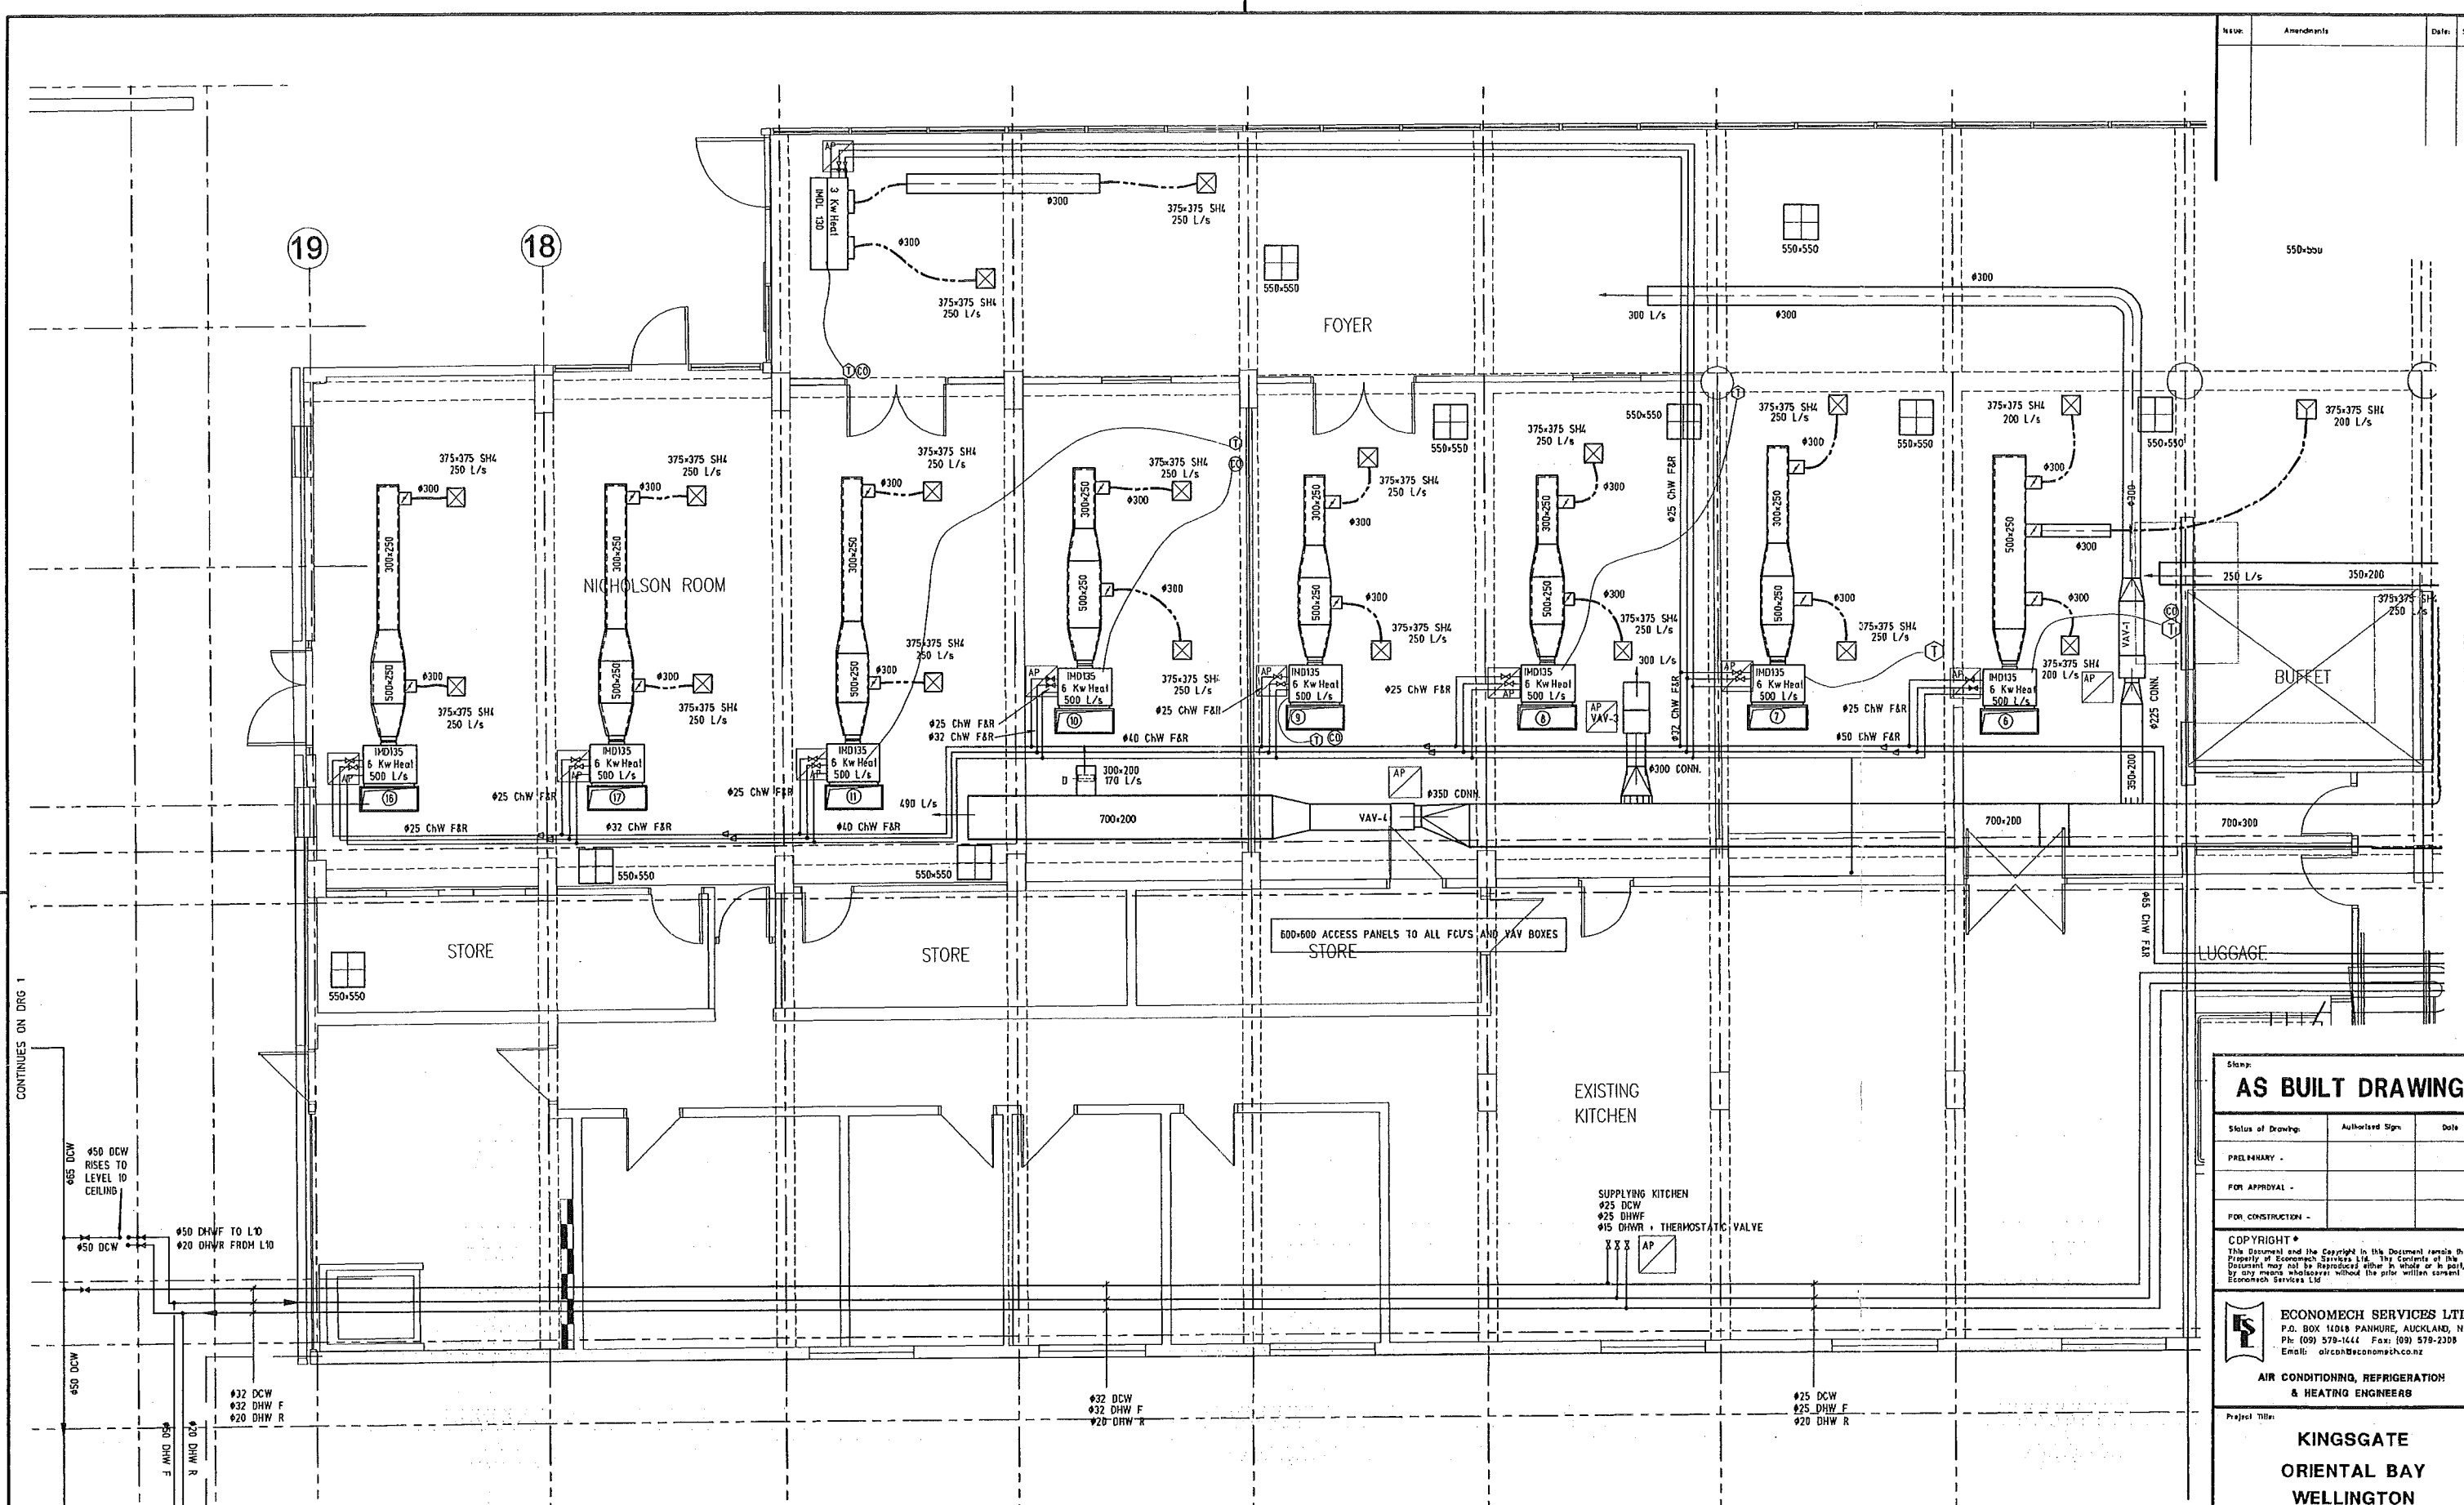

Wellington City Council
21 April 2021

AS BUILT DRAWING
DECEMBER 2007
THIS DRAWING IS A TRUE AND ACCURATE
RECORD OF THE AS INSTALLED MECHANICAL
SERVICES SYSTEM
Signed WH

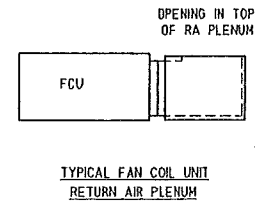


Stamp: AS BUILT DRAWING		
Status of Drawing:	Authorised Sign:	Date:
PRELIMINARY -		
FOR APPROVAL -		
FOR CONSTRUCTION -		
COPYRIGHT © This document and the Copyright in this document remain the Property of Economech Services Ltd. The Contents of this Document may not be reproduced either in whole or in part, by any means whatsoever without the prior written consent of Economech Services Ltd.		
ECONOMECH SERVICES LTD P.O. BOX 11018 PAKHURE, AUCKLAND, NZ Ph: (09) 578-1444 Fax: (09) 578-2308 Email: aircon@economech.co.nz AIR CONDITIONING, REFRIGERATION & HEATING ENGINEERS		
Project Title: KINGSGATE ORIENTAL BAY WELLINGTON		
Sheet Title: MECHANICAL SERVICES ROXBURGH WING LEVEL 7 PART 2		
Drawn: RC	Cod File: 1404-7.dwg	
Date: OCT'07	Scale at A1: 1:25 Scale at A3: 1:50	
Drawing No: 1404-R7-2	Rev: -	

CONTINUES ON DRG 1

CONTINUES ON DRG 3

Wellington City Council
21 April 2021

Issue	Amendments	Date	Sign

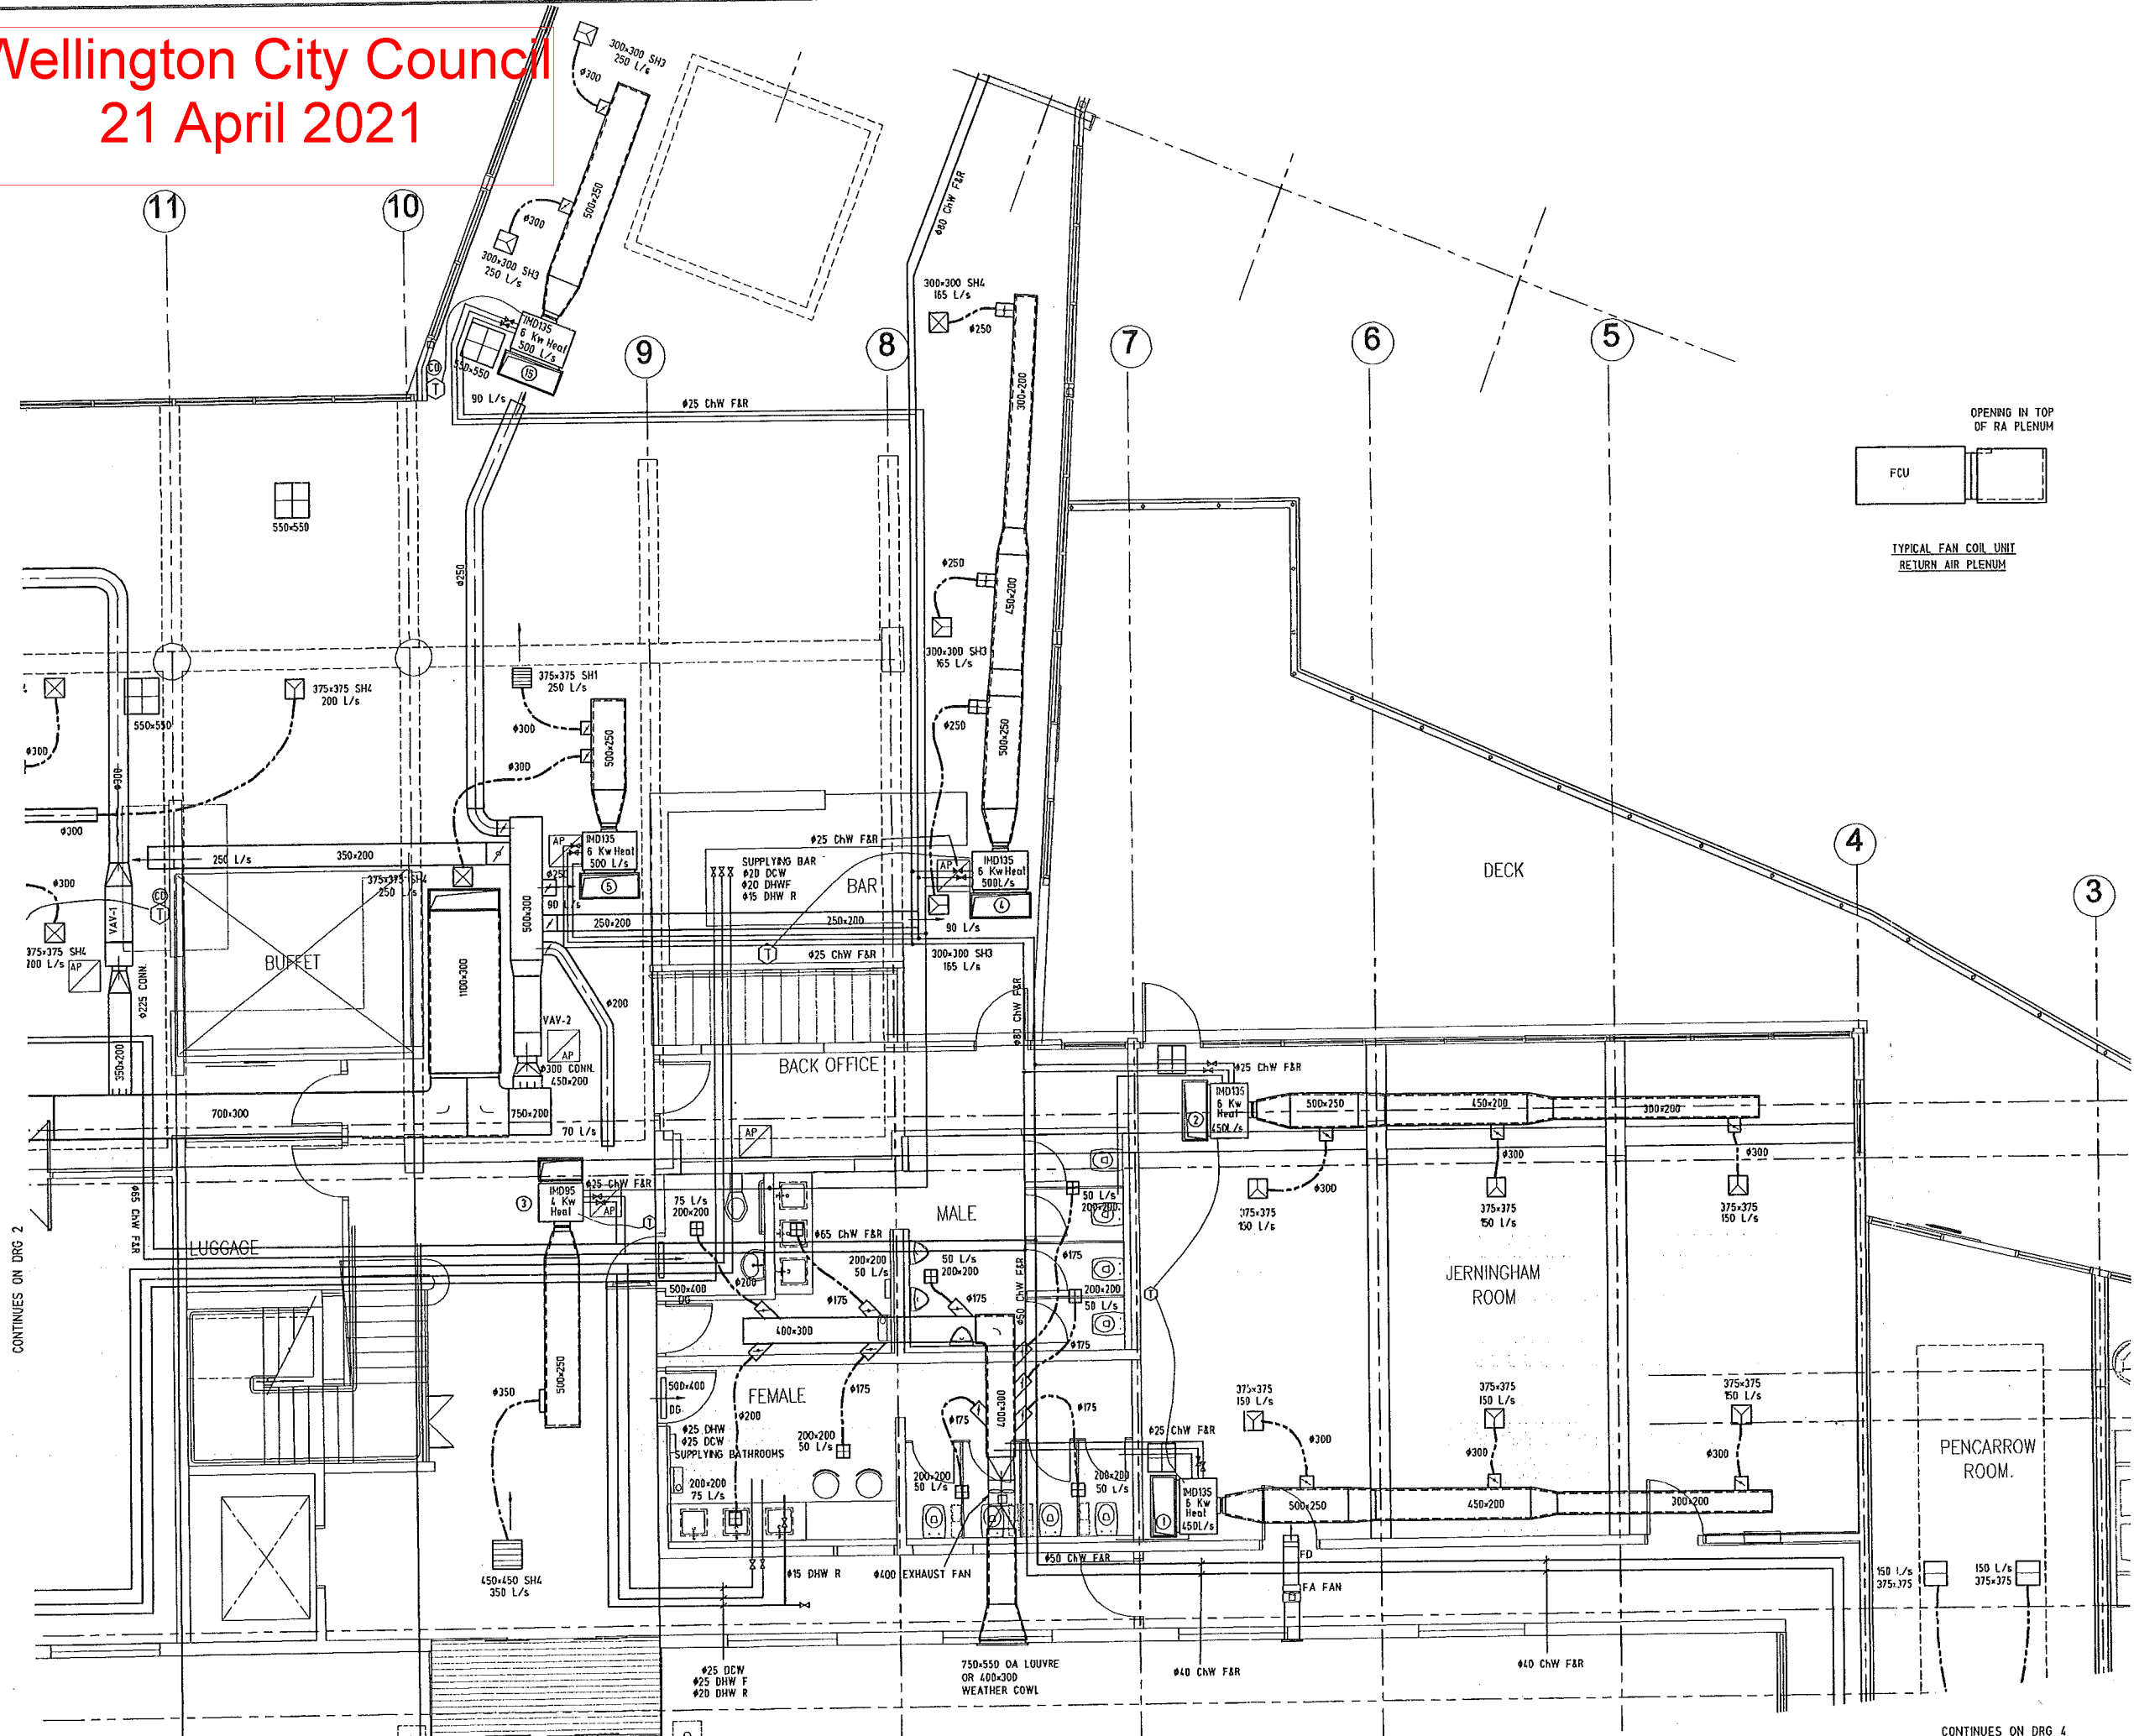

AS BUILT DRAWING
DECEMBER 2007
THIS DRAWING IS A TRUE AND ACCURATE
RECORD OF THE AS INSTALLED MECHANICAL
SERVICES SYSTEM
Signed WH

AS BUILT DRAWING

Status of Drawing	Authorized Sign	Date
PRELIMINARY -		
FOR APPROVAL -		
FOR CONSTRUCTION -		

COPYRIGHT
This Document and the Copyright in this Document remain the
Property of Economech Services Ltd. The Contents of this
Document may not be reproduced either in whole or in part,
by any means whatsoever without the prior written consent of
Economech Services Ltd.

ECONOMECH SERVICES LTD
P.O. BOX 1048 PANMURE, AUCKLAND, NZ
Ph: (09) 579-1444 Fax: (09) 579-2308
Email: alrcan@economech.co.nz

**AIR CONDITIONING, REFRIGERATION
& HEATING ENGINEERS**

Project Title:
**KINGSGATE
ORIENTAL BAY
WELLINGTON**

Sheet Title:
**MECHANICAL SERVICES
ROXBURGH WING
LEVEL 7 PART 3**


Drawn: **RC** Cod. No. 1404-7-4WB
Date: **OCT'07** Scale at A1: 1:50
Scale at A3: 1:100

Drawing No. **1404-R7-3**

CONTINUES ON DRG 2

CONTINUES ON DRG 4

Issue	Amendments	Date	Sign

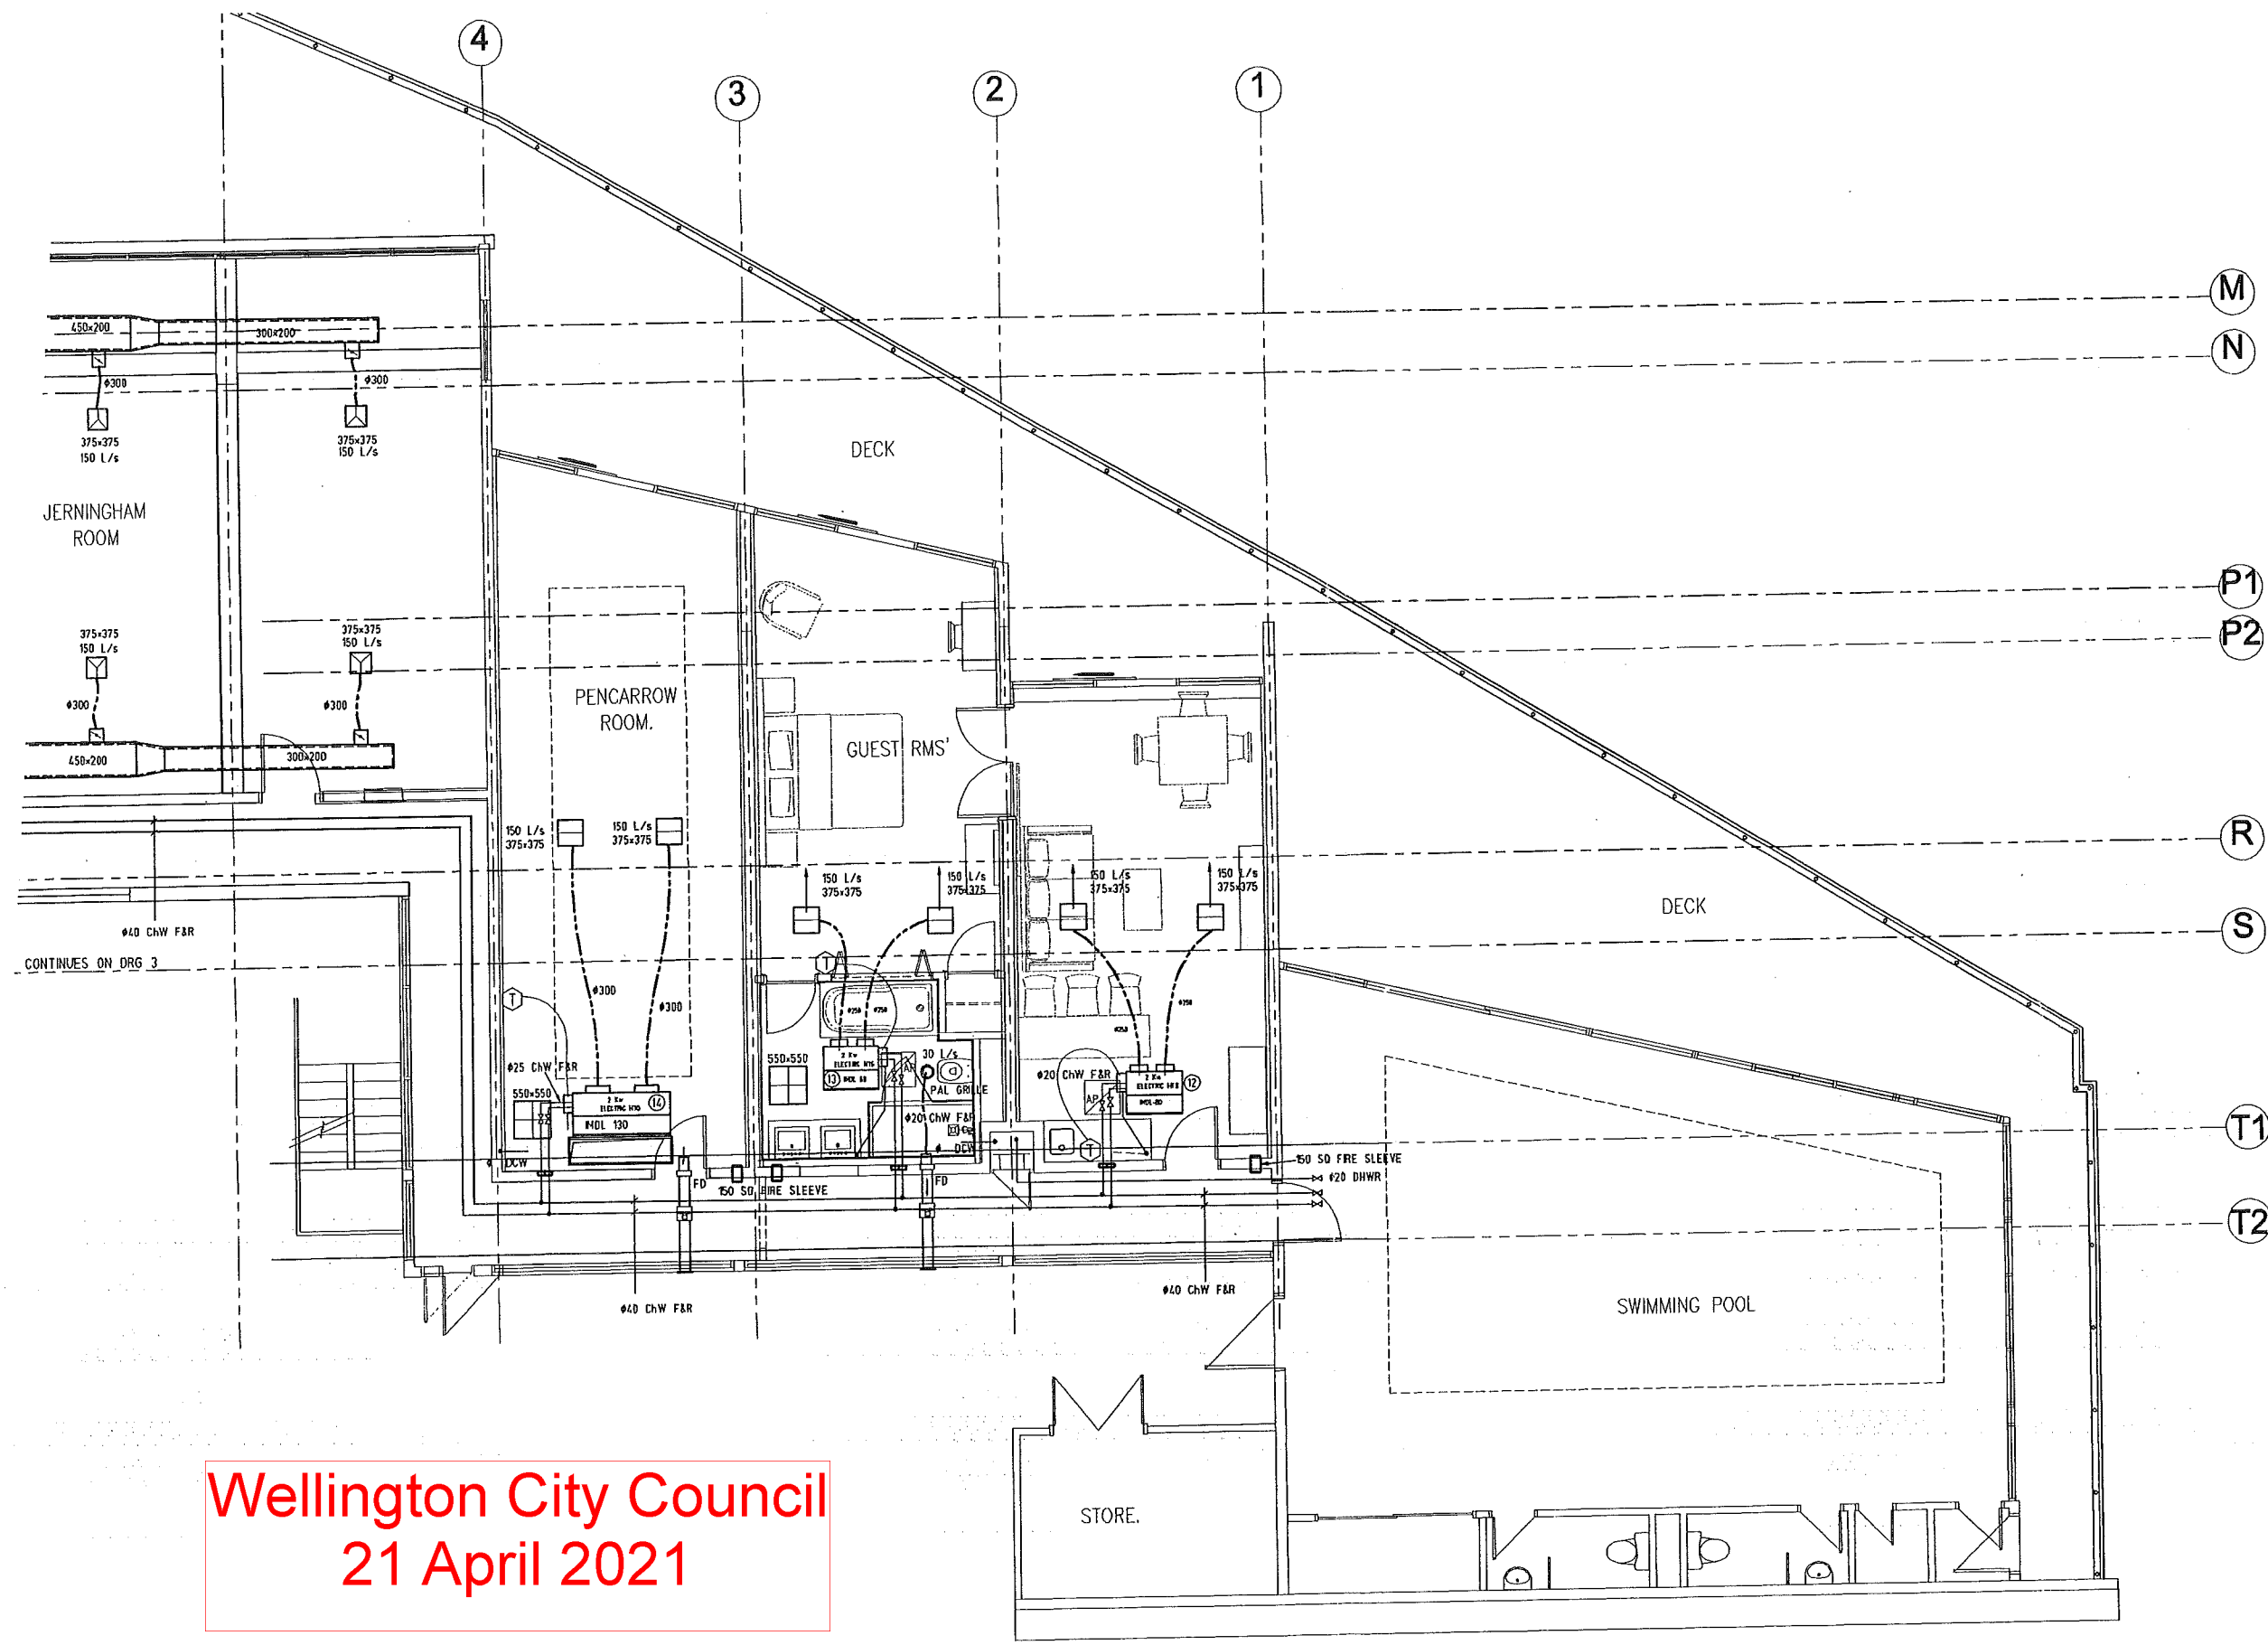

AS BUILT DRAWING
 DECEMBER 2007
 THIS DRAWING IS A TRUE AND ACCURATE
 RECORD OF THE AS INSTALLED MECHANICAL
 SERVICES SYSTEM
 Signed WH

Stamp:
AS BUILT DRAWING

Status of Drawing	Authorized Sign	Date
PRELIMINARY -		
FOR APPROVAL -		
FOR CONSTRUCTION -		

COPYRIGHT
 This Document and the Copyright in this Document remain the
 Property of Economech Services Ltd. The Contents of this
 Document may not be Reproduced either in whole or in part,
 for any means whatsoever without the prior written consent of
 Economech Services Ltd.

ECONOMECH SERVICES LTD
 P.O. BOX 10018 PANHURE, AUCKLAND, NZ
 Ph: (09) 579-1444 Fax: (09) 579-2308
 Email: a@economech.co.nz

**AIR CONDITIONING, REFRIGERATION
 & HEATING ENGINEERS**


Project Title:
**KINGSGATE
 ORIENTAL BAY
 WELLINGTON**

Sheet Title:
**MECHANICAL SERVICES
 ROXBURGH WING
 LEVEL 7 PART 4**

Drawn: RC	Col File: 1404-7.dwg
Date: OCT'07	Scale of A1: 1:50 Scale of A3: 1:100
Drawing No: 1404-R7-4	Rev: -

**Wellington City Council
 21 April 2021**

Wellington City Council
21 April 2021

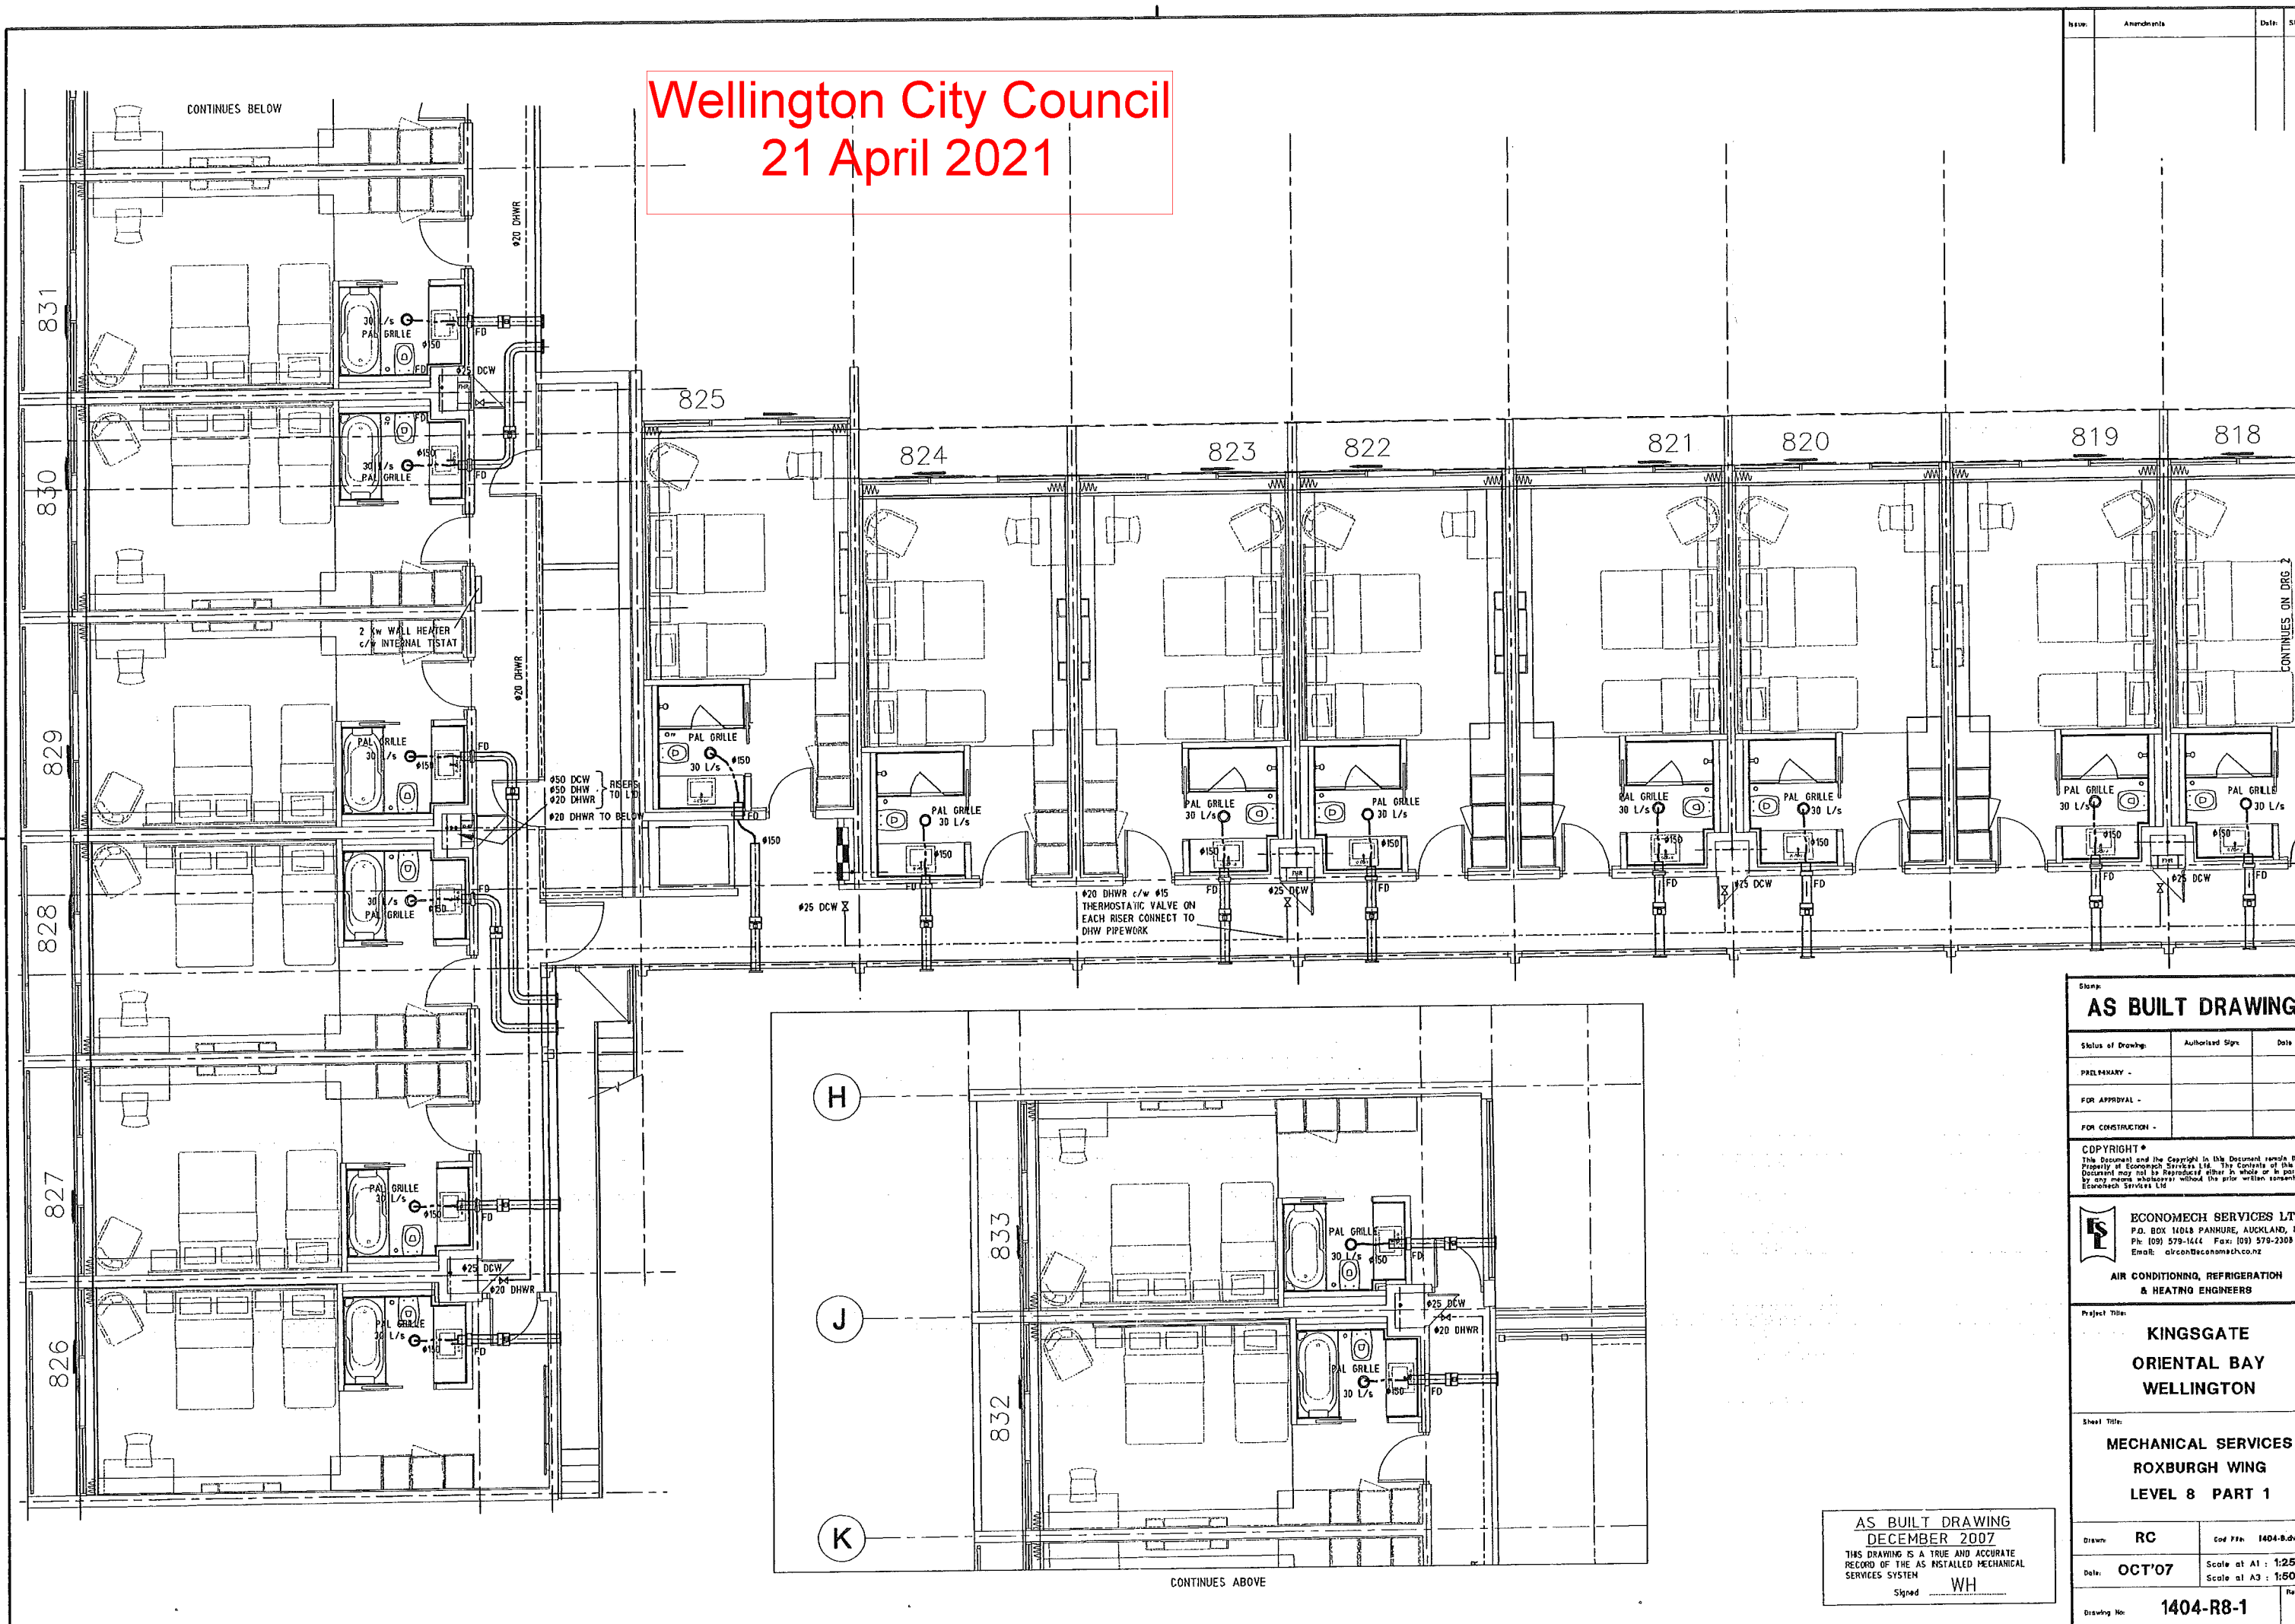

Rev	Amendments	Date	Sign

AS BUILT DRAWING

Status of Drawing	Authorised Sign	Date
PRELIMINARY -		
FOR APPROVAL -		
FOR CONSTRUCTION -		

COPYRIGHT
This Document and the Copyright in this Document remain the property of Economech Services Ltd. The Contents of this Document may not be reproduced either in whole or in part, by any means whatsoever without the prior written consent of Economech Services Ltd.

ECONOMECH SERVICES LTD
P.O. BOX 1404 PANMURE, AUCKLAND, NZ
Ph: (09) 579-1444 Fax: (09) 579-2308
Email: alcon@economech.co.nz

AIR CONDITIONING, REFRIGERATION & HEATING ENGINEERS


Project Title:
**KINGSGATE
ORIENTAL BAY
WELLINGTON**

Sheet Title:
**MECHANICAL SERVICES
ROXBURGH WING
LEVEL 8 PART 1**


**AS BUILT DRAWING
DECEMBER 2007**
THIS DRAWING IS A TRUE AND ACCURATE RECORD OF THE AS INSTALLED MECHANICAL SERVICES SYSTEM
Signed WH

Drawn: RC	Conc. Ptn: 1404-R8.dwg
Date: OCT'07	Scale at A1: 1:25 Scale at A3: 1:50
Drawing No: 1404-R8-1	Rev: -

Issue:	Amendments	Date:	Sign:

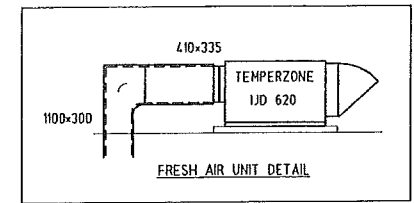

600 to 1800 L/s MAX
c/w 18kW ELECTRIC HEATING
3 STAGE :
OA - 4°C 3 STAGES ON
DA - 7°C 2 STAGES ON
DA - 10°C 1 STAGE ON
VSD CONTROLLED
INLET WEATHER COWL

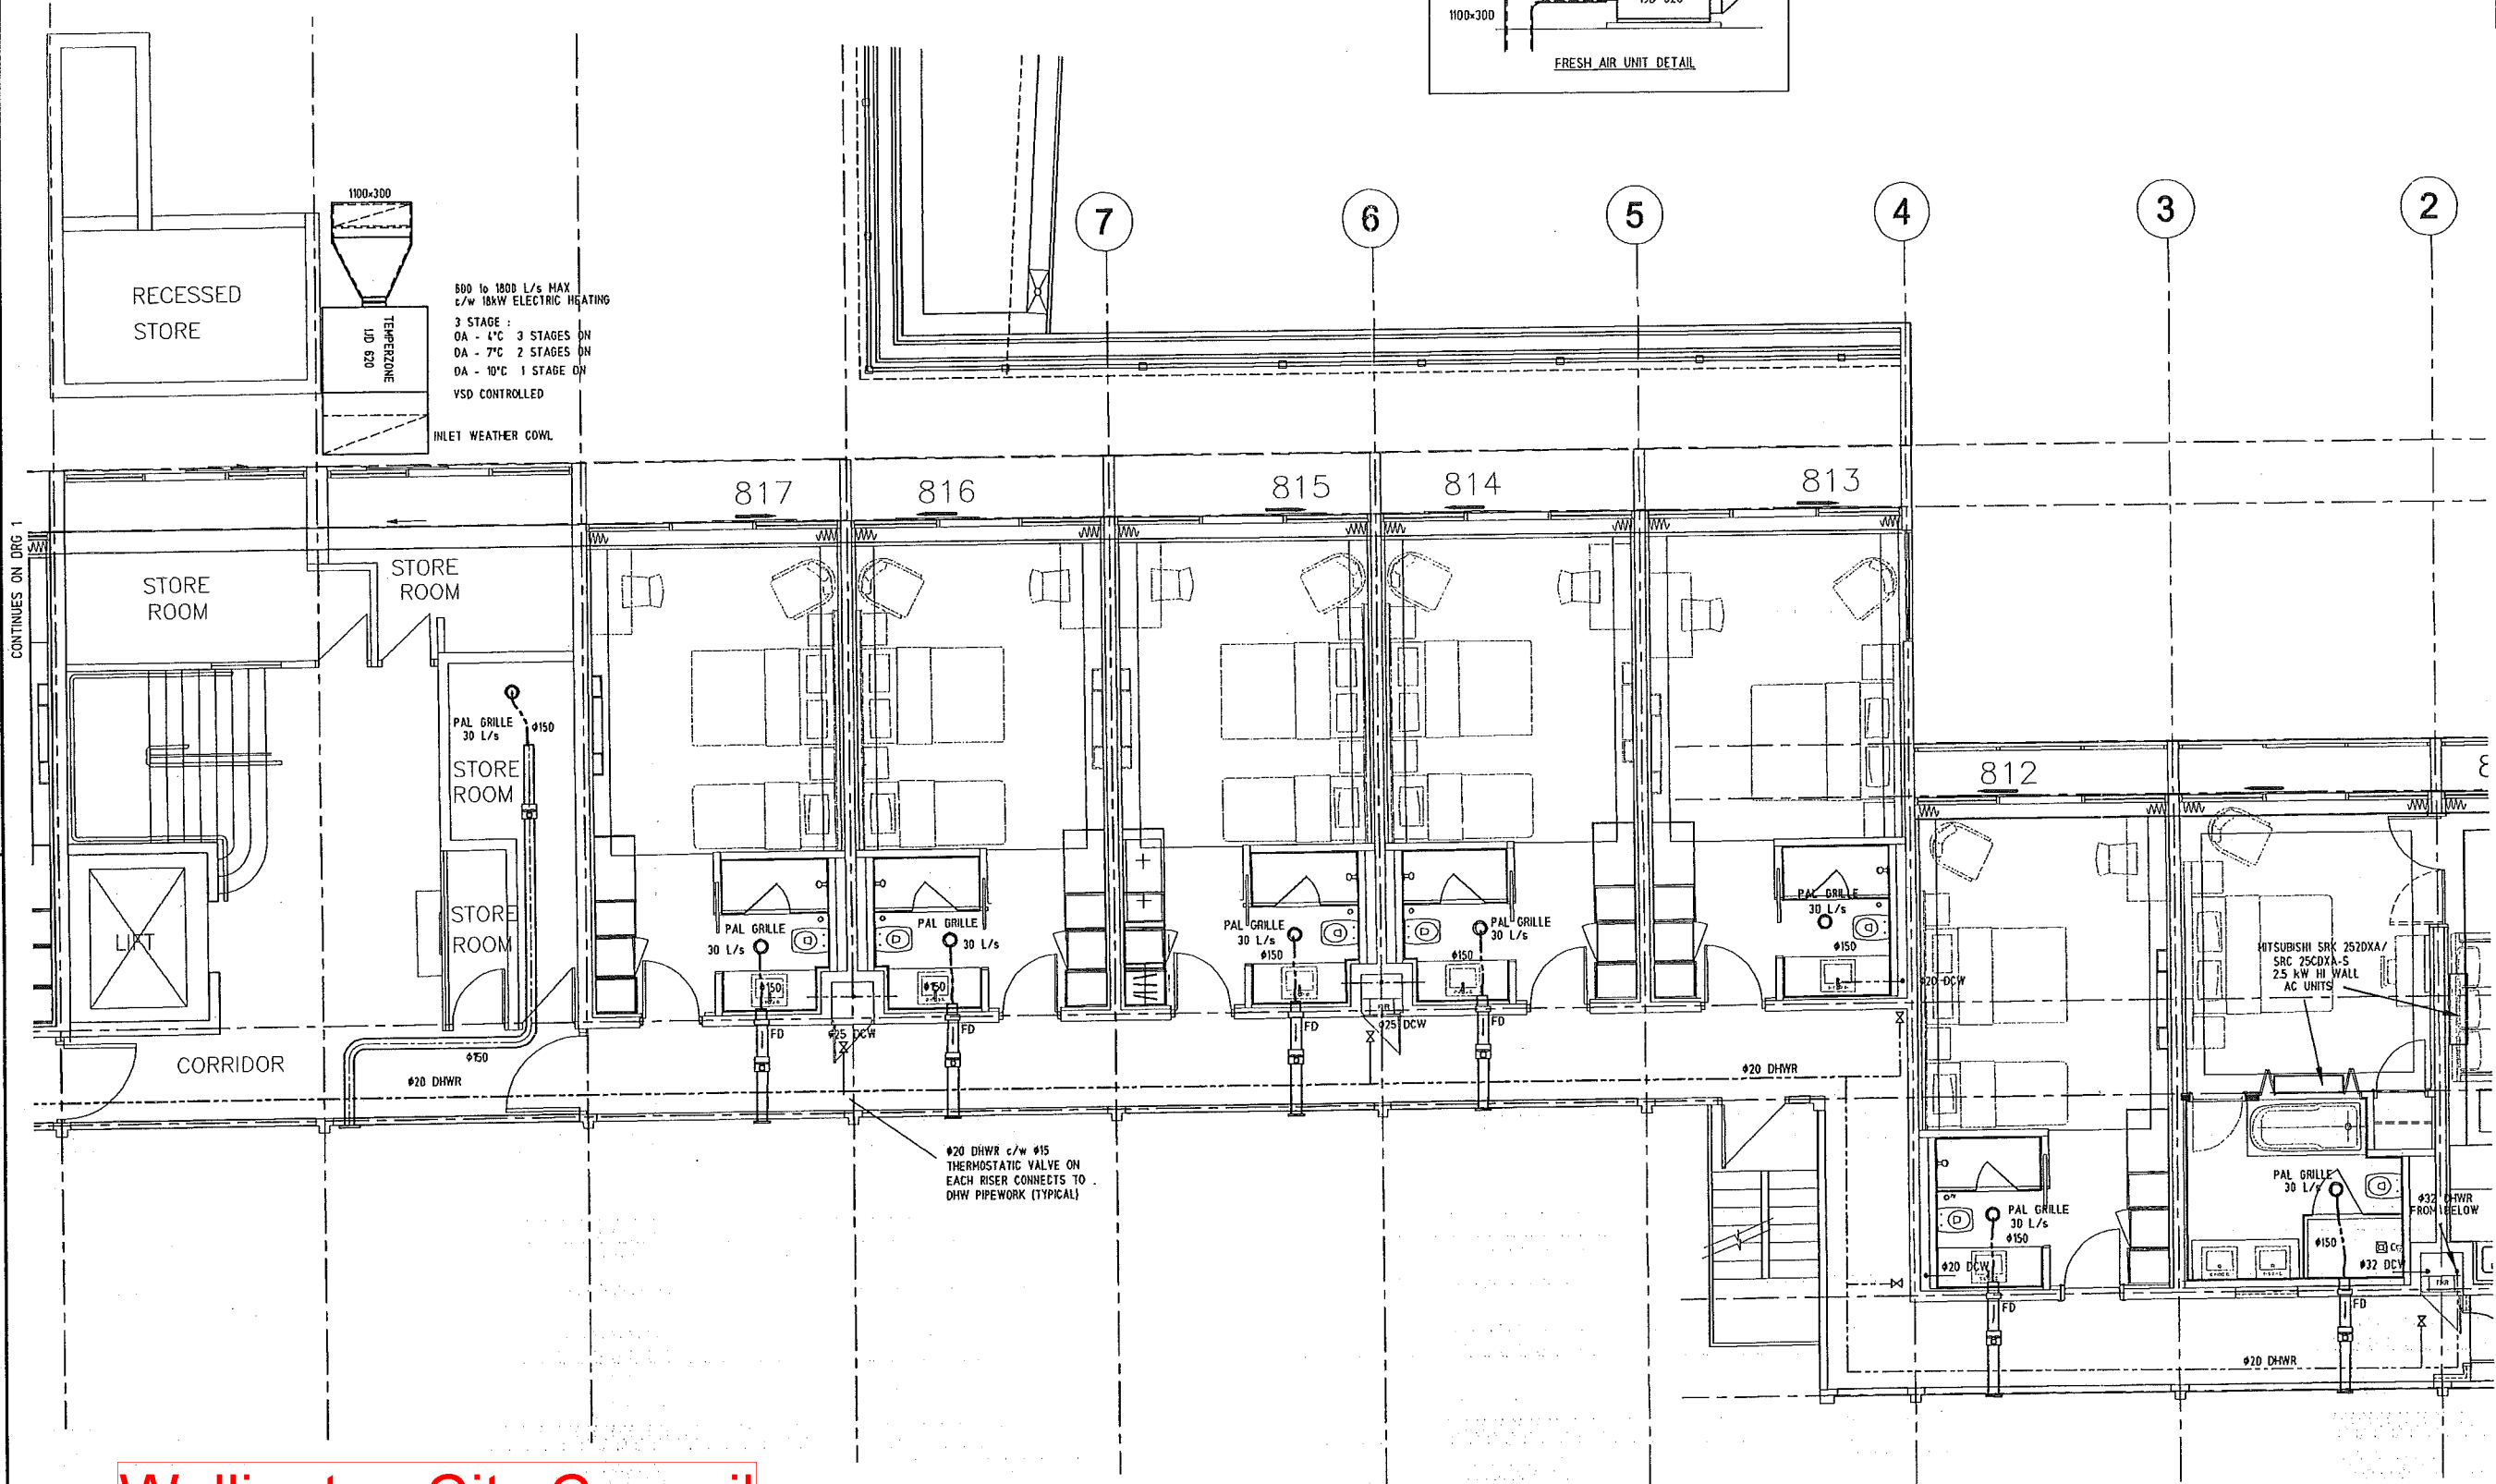

AS BUILT DRAWING
DECEMBER 2007
THIS DRAWING IS A TRUE AND ACCURATE RECORD OF THE AS INSTALLED MECHANICAL SERVICES SYSTEM
Signed: WH

Stamp:
AS BUILT DRAWING

Status of Drawing:	Authorized Sign:	Date:
PRELIMINARY -		
FOR APPROVAL -		
FOR CONSTRUCTION -		

COPYRIGHT
This Document and the Copyright in this Document remain the Property of Economech Services Ltd. The Contents of this Document may not be reproduced either in whole or in part, by any means whatsoever without the prior written consent of Economech Services Ltd.

ECONOMECH SERVICES LTD
P.O. BOX 11018 PANMURE, AUCKLAND, NZ
Ph: (09) 579-1414 Fax: (09) 579-2309
Email: aircon@economech.co.nz

AIR CONDITIONING, REFRIGERATION & HEATING ENGINEERS

Project Title:
**KINGSGATE
ORIENTAL BAY
WELLINGTON**

Sheet Title:
**MECHANICAL SERVICES
ROXBURGH WING
LEVEL 8 PART 2**


Drawn: **RC** Cad File: 1404-R8.dwg

Date: **OCT'07** Scale at A1: 1:25
Scale at A3: 1:50

Drawing No: **1404-R8-2** Rev: -

Wellington City Council
21 April 2021

Issue	Amendments	Date	Sign

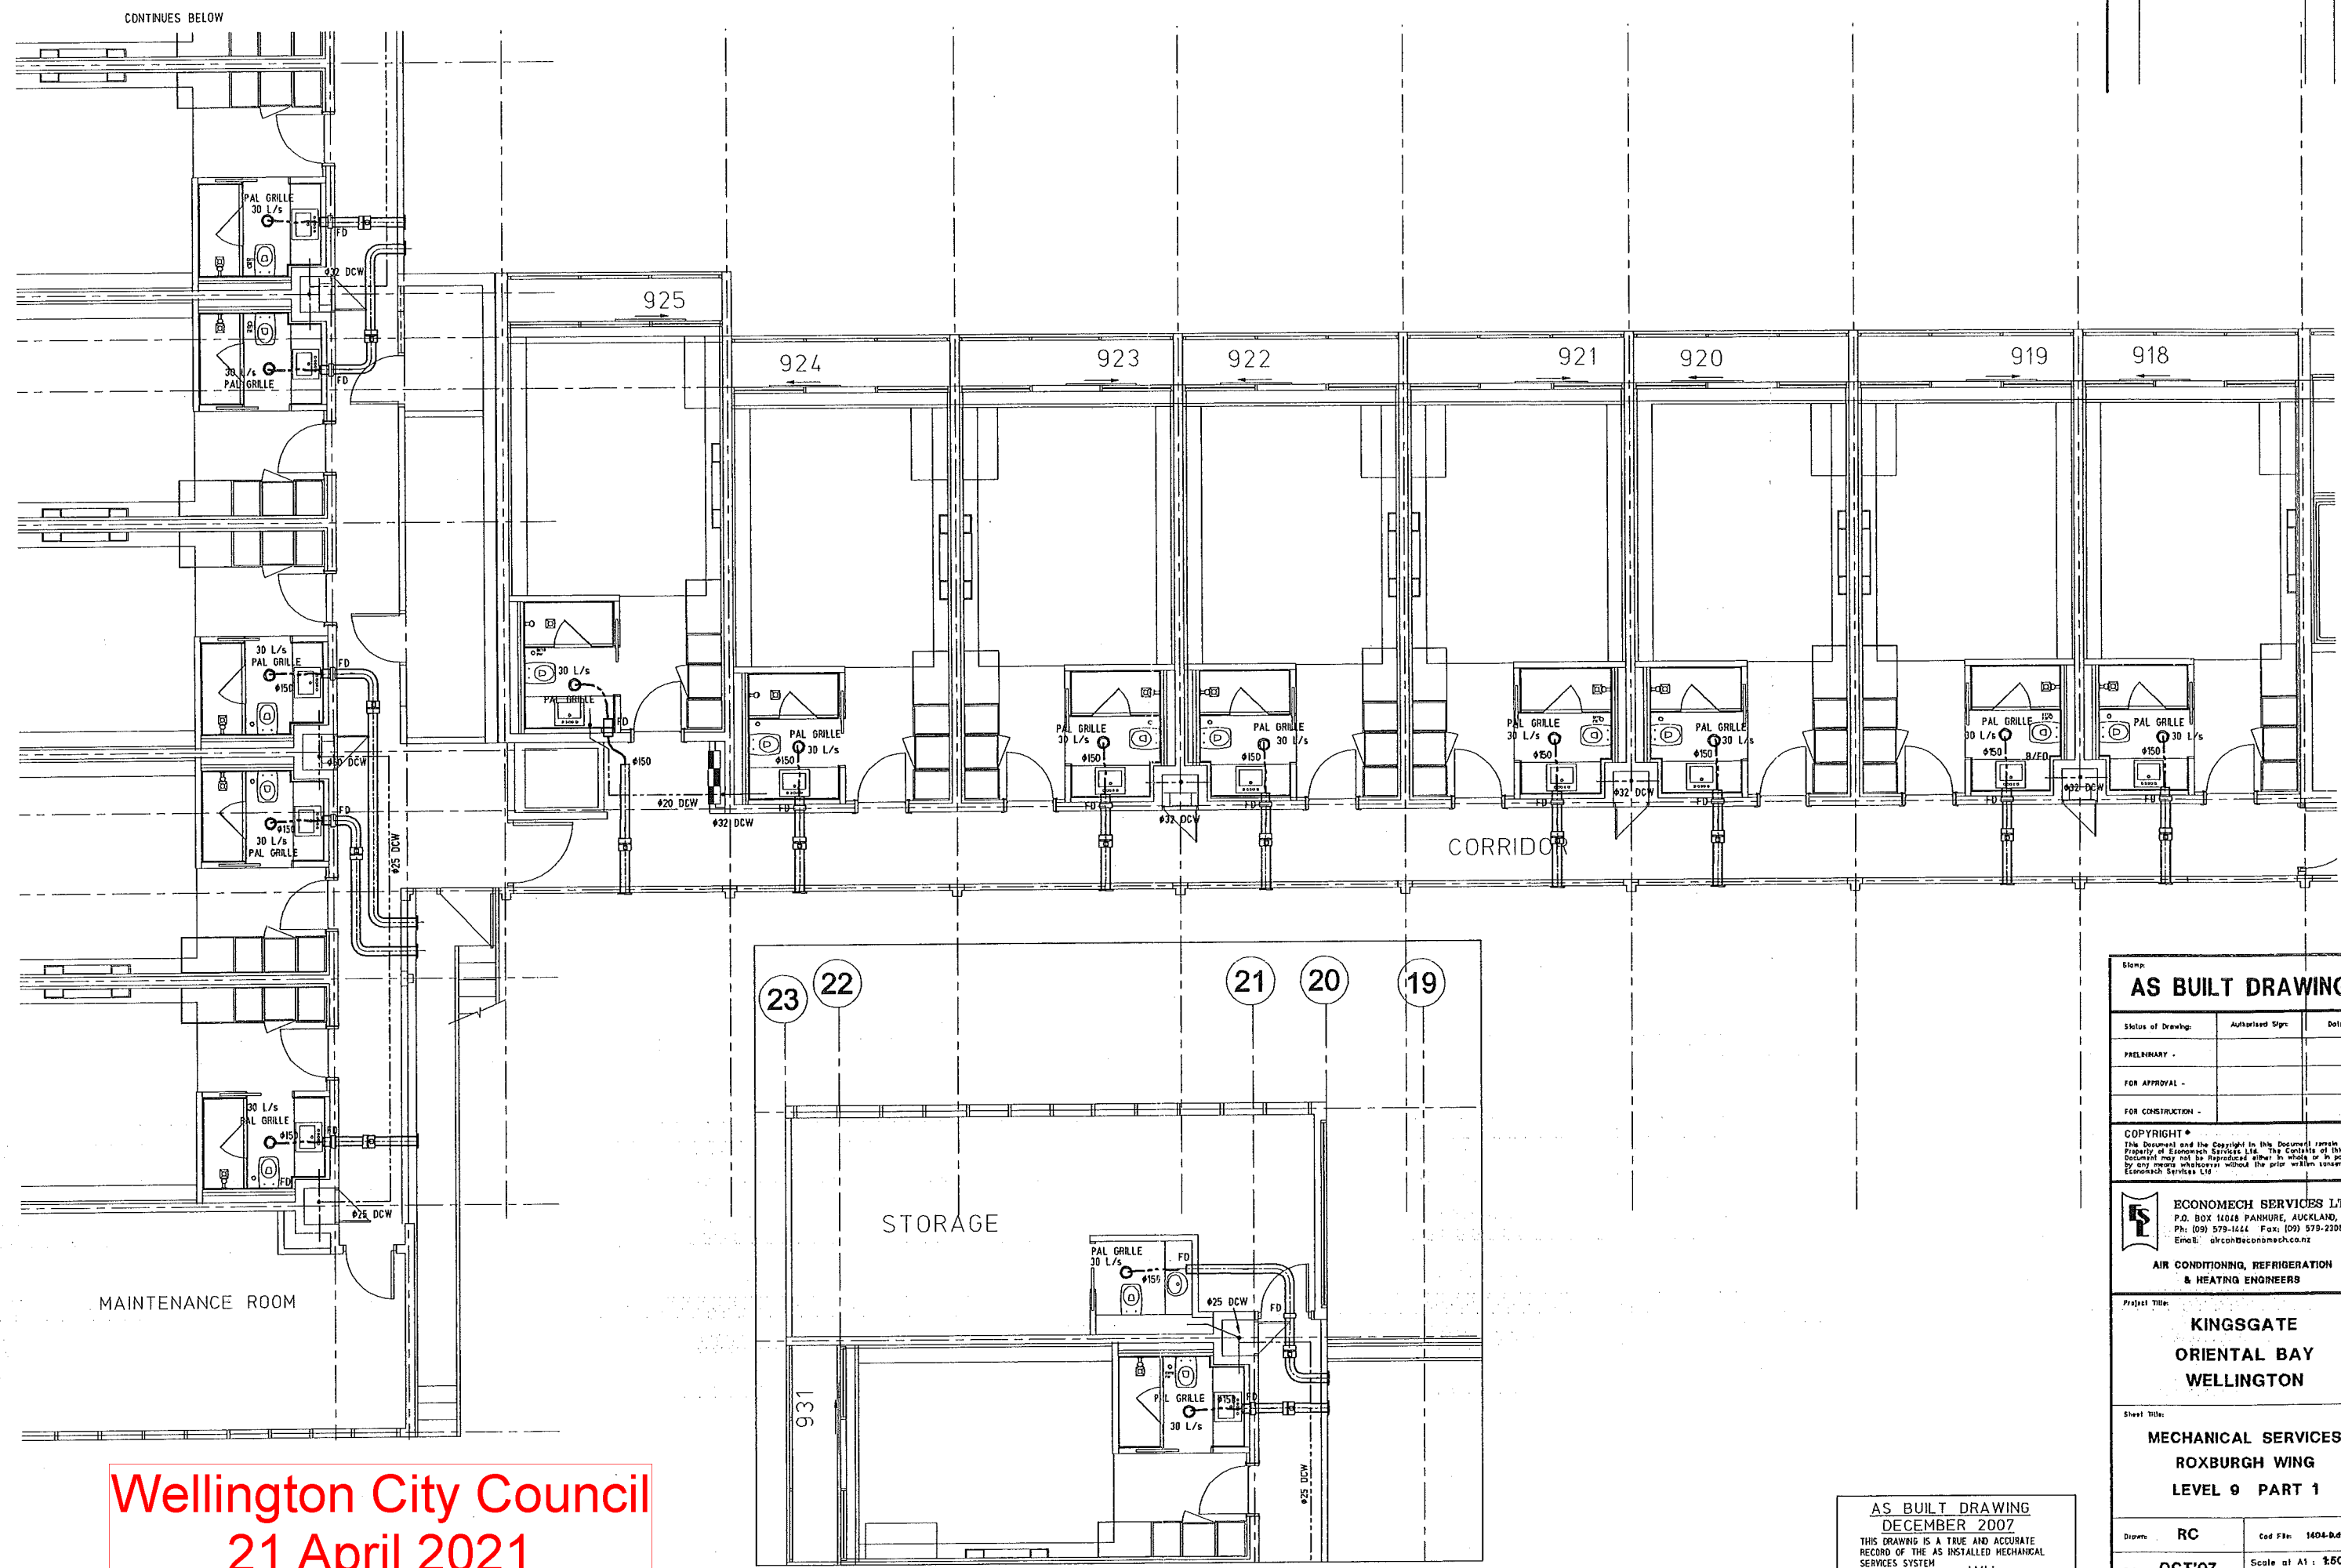

Wellington City Council
21 April 2021

AS BUILT DRAWING
DECEMBER 2007
THIS DRAWING IS A TRUE AND ACCURATE
RECORD OF THE AS INSTALLED MECHANICAL
SERVICES SYSTEM
Signed WH

Slomp: **AS BUILT DRAWING**

Status of Drawing	Authorized Sign	Date
PRELIMINARY -		
FOR APPROVAL -		
FOR CONSTRUCTION -		

COPYRIGHT
This Document and the Copyright in this Document remain the Property of Economech Services Ltd. The Contents of this Document may not be reproduced, stored in a retrieval system, or transmitted in any form or by any means whatsoever without the prior written consent of Economech Services Ltd.

ECONOMECH SERVICES LTD
P.O. BOX 14018 PARNHUR, AUCKLAND, NZ
Ph: (09) 579-1441 Fax: (09) 579-2308
Email: alicon@economech.co.nz


**AIR CONDITIONING, REFRIGERATION
& HEATING ENGINEERS**

Project Title:
**KINGSGATE
ORIENTAL BAY
WELLINGTON**

Sheet Title:
**MECHANICAL SERVICES
ROXBURGH WING
LEVEL 9 PART 1**

Drawn: RC	Cad File: 1404-R9.dwg
Date: OCT'07	Scale at A1: 1:50 Scale at A3: 1:100
Drawing No: 1404-R9-1	Rev: -

Issue	Amendments	Date	Sign

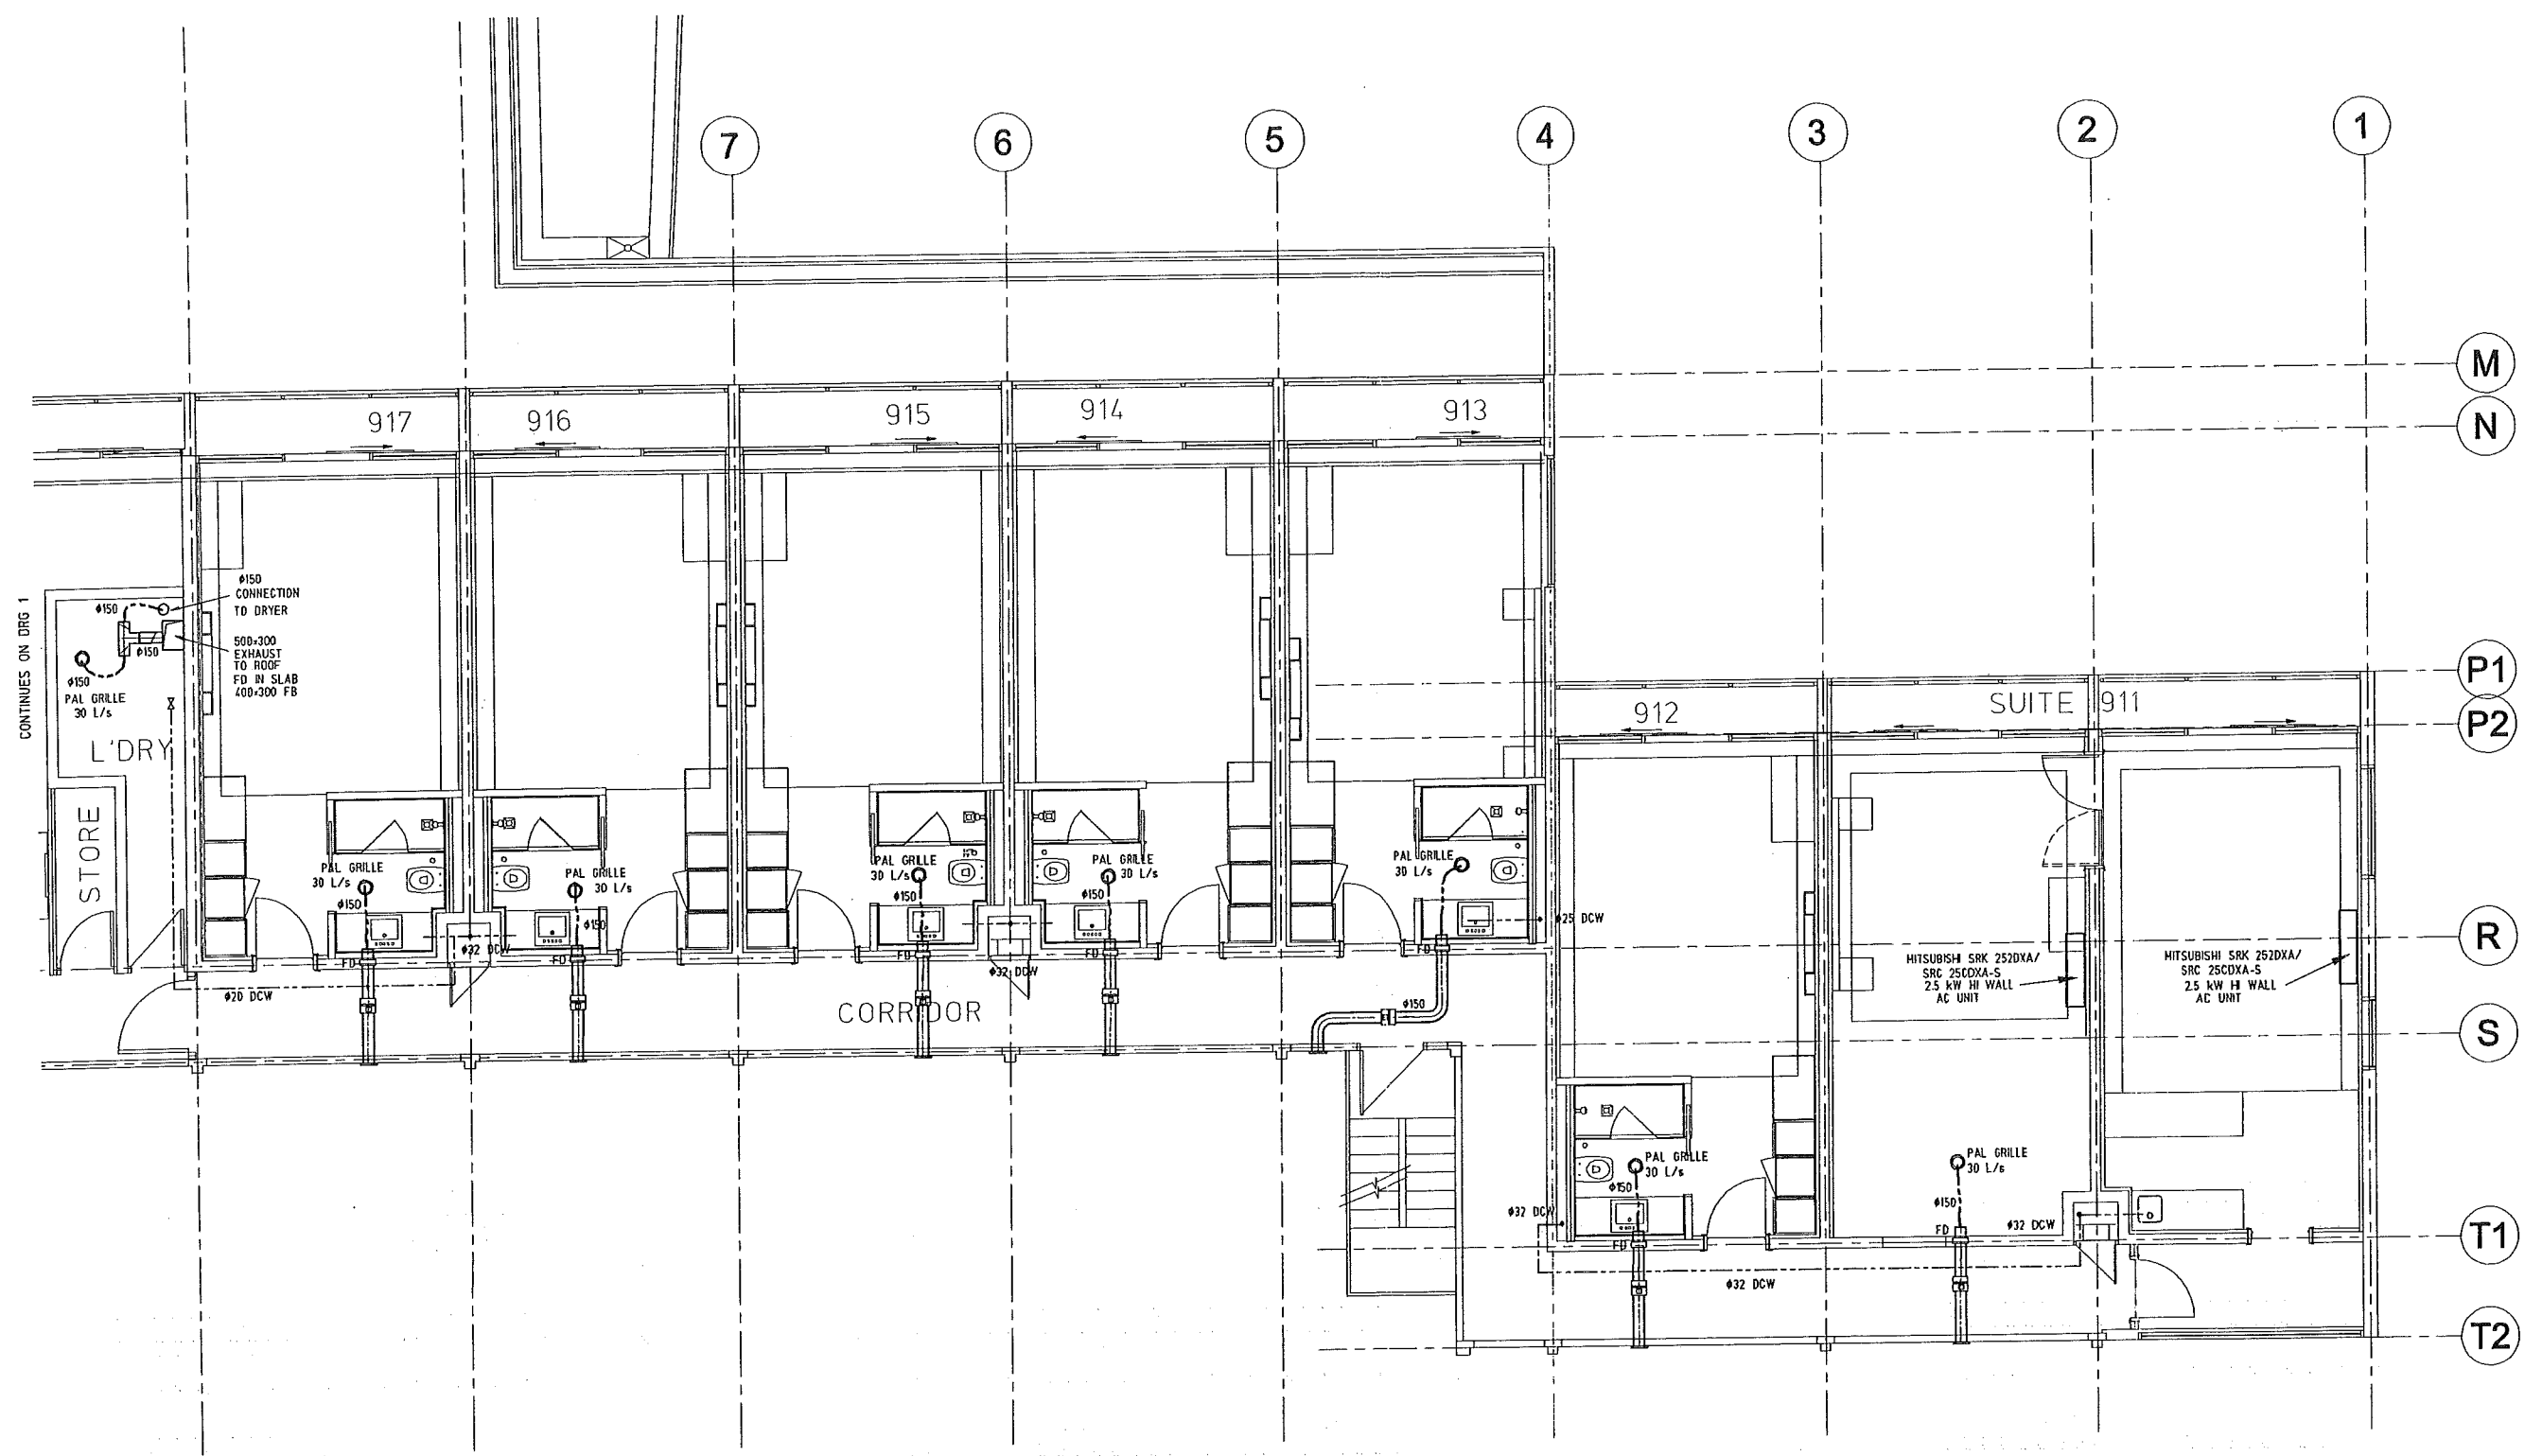

AS BUILT DRAWING
 DECEMBER 2007
 THIS DRAWING IS A TRUE AND ACCURATE
 RECORD OF THE AS INSTALLED MECHANICAL
 SERVICES SYSTEM
 Signed WH

Stamp:
AS BUILT DRAWING

Status of Drawing:	Authorised Sign:	Date:
PRELIMINARY -		
FOR APPROVAL -		
FOR CONSTRUCTION -		

COPYRIGHT
 This Document and the Copyright in this Document remain the
 property of Economech Services Ltd. The contents of this
 Document may not be reproduced either in whole or in part,
 by any means whatsoever without the prior written consent of
 Economech Services Ltd.

ECONOMECH SERVICES LTD
 P.O. BOX 1404 PANHURE, AUCKLAND, NZ
 Ph: (09) 579-1444 Fax: (09) 579-2309
 Email: alcon@economech.co.nz

**AIR CONDITIONING, REFRIGERATION
 & HEATING ENGINEERS**


Project Title:
**KINGSGATE
 ORIENTAL BAY
 WELLINGTON**

Sheet Title:
**MECHANICAL SERVICES
 ROXBURGH WING
 LEVEL 9 PART 2**


Drawn: RC	Col File: 1404-R9.dwg
Date: OCT'07	Scale at A1: 1:50 Scale at A3: 1:100
Drawing No: 1404-R9-2	Rev: -

Wellington City Council
21 April 2021


Issue	Amendments	Date	Sign

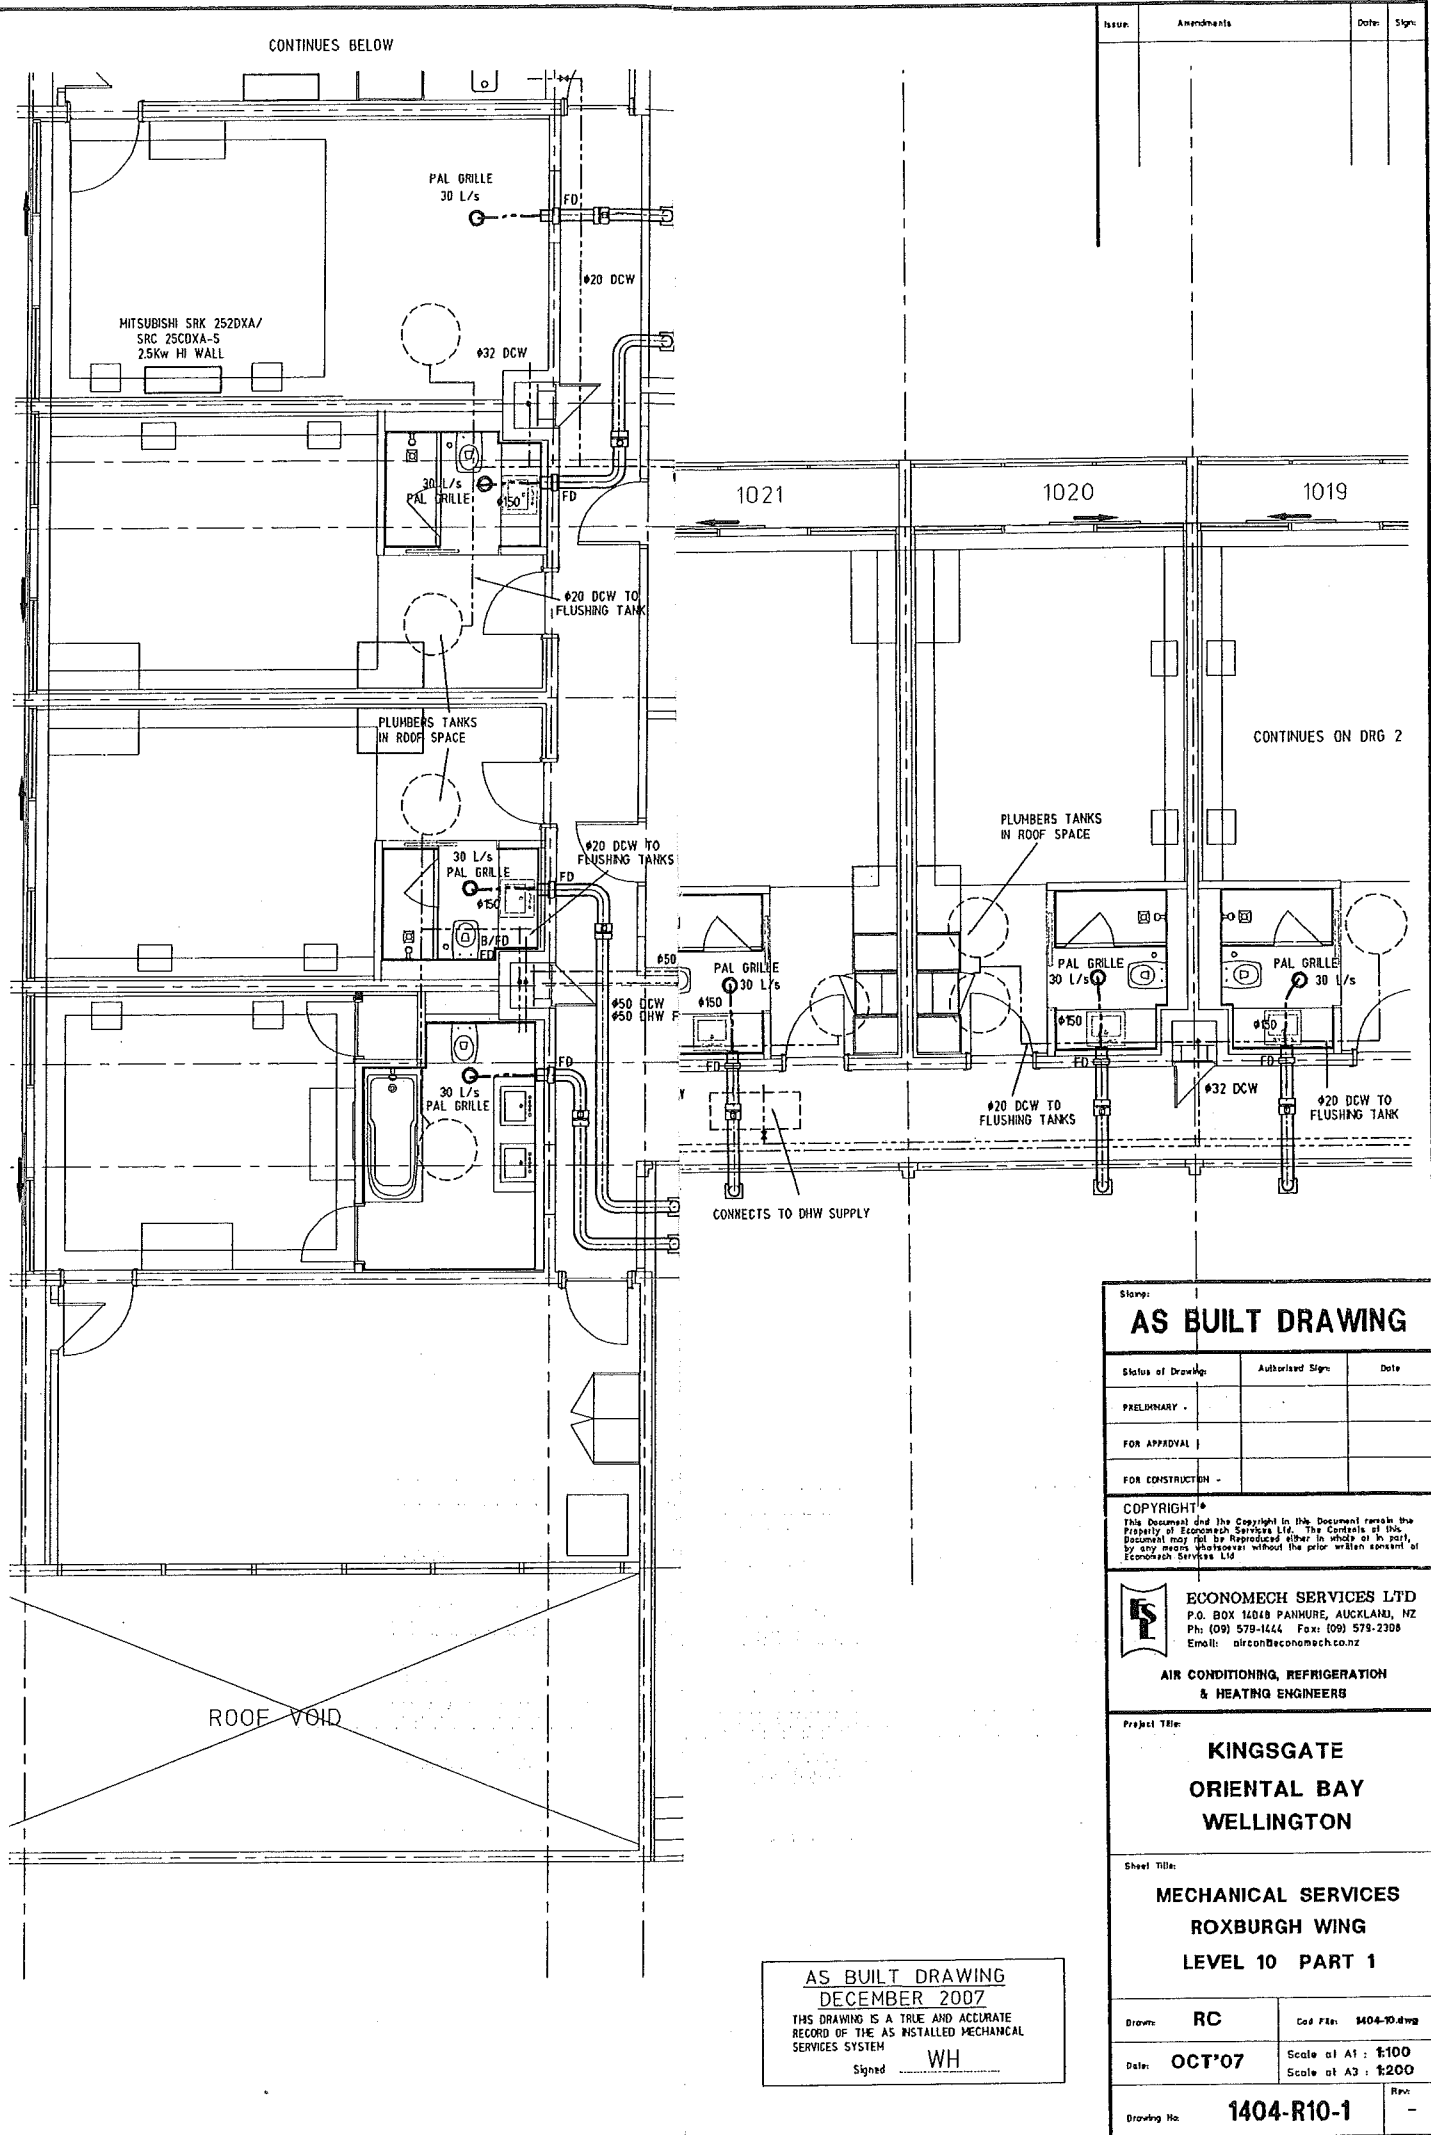

AS BUILT DRAWING
 DECEMBER 2007
 THIS DRAWING IS A TRUE AND ACCURATE
 RECORD OF THE AS INSTALLED MECHANICAL
 SERVICES SYSTEM
 Signed WH

Store:		
AS BUILT DRAWING		
Status of Drawing:	Authorized Sign:	Date:
PRELIMINARY -		
FOR APPROVAL		
FOR CONSTRUCTION -		
COPYRIGHT <small>This document and the copyright in this document remain the property of Economech Services Ltd. The contents of this document may not be reproduced either in whole or in part, by any means whatsoever without the prior written consent of Economech Services Ltd.</small>		
 ECONOMECH SERVICES LTD P.O. BOX 14848 PARNHUR, AUCKLAND, NZ Ph: (09) 579-1444 Fax: (09) 579-2308 Email: aircon@economech.co.nz		
AIR CONDITIONING, REFRIGERATION & HEATING ENGINEERS		
Project Title:		
KINGSGATE ORIENTAL BAY WELLINGTON		
Sheet Title:		
MECHANICAL SERVICES ROXBURGH WING LEVEL 10 PART 1		
Drawn: RC	Col File: 1404-R10.dwg	
Date: OCT'07	Scale at A1: 1:100	
	Scale at A3: 1:200	
Drawing No: 1404-R10-1		Rev: -

Wellington City Council
21 April 2021

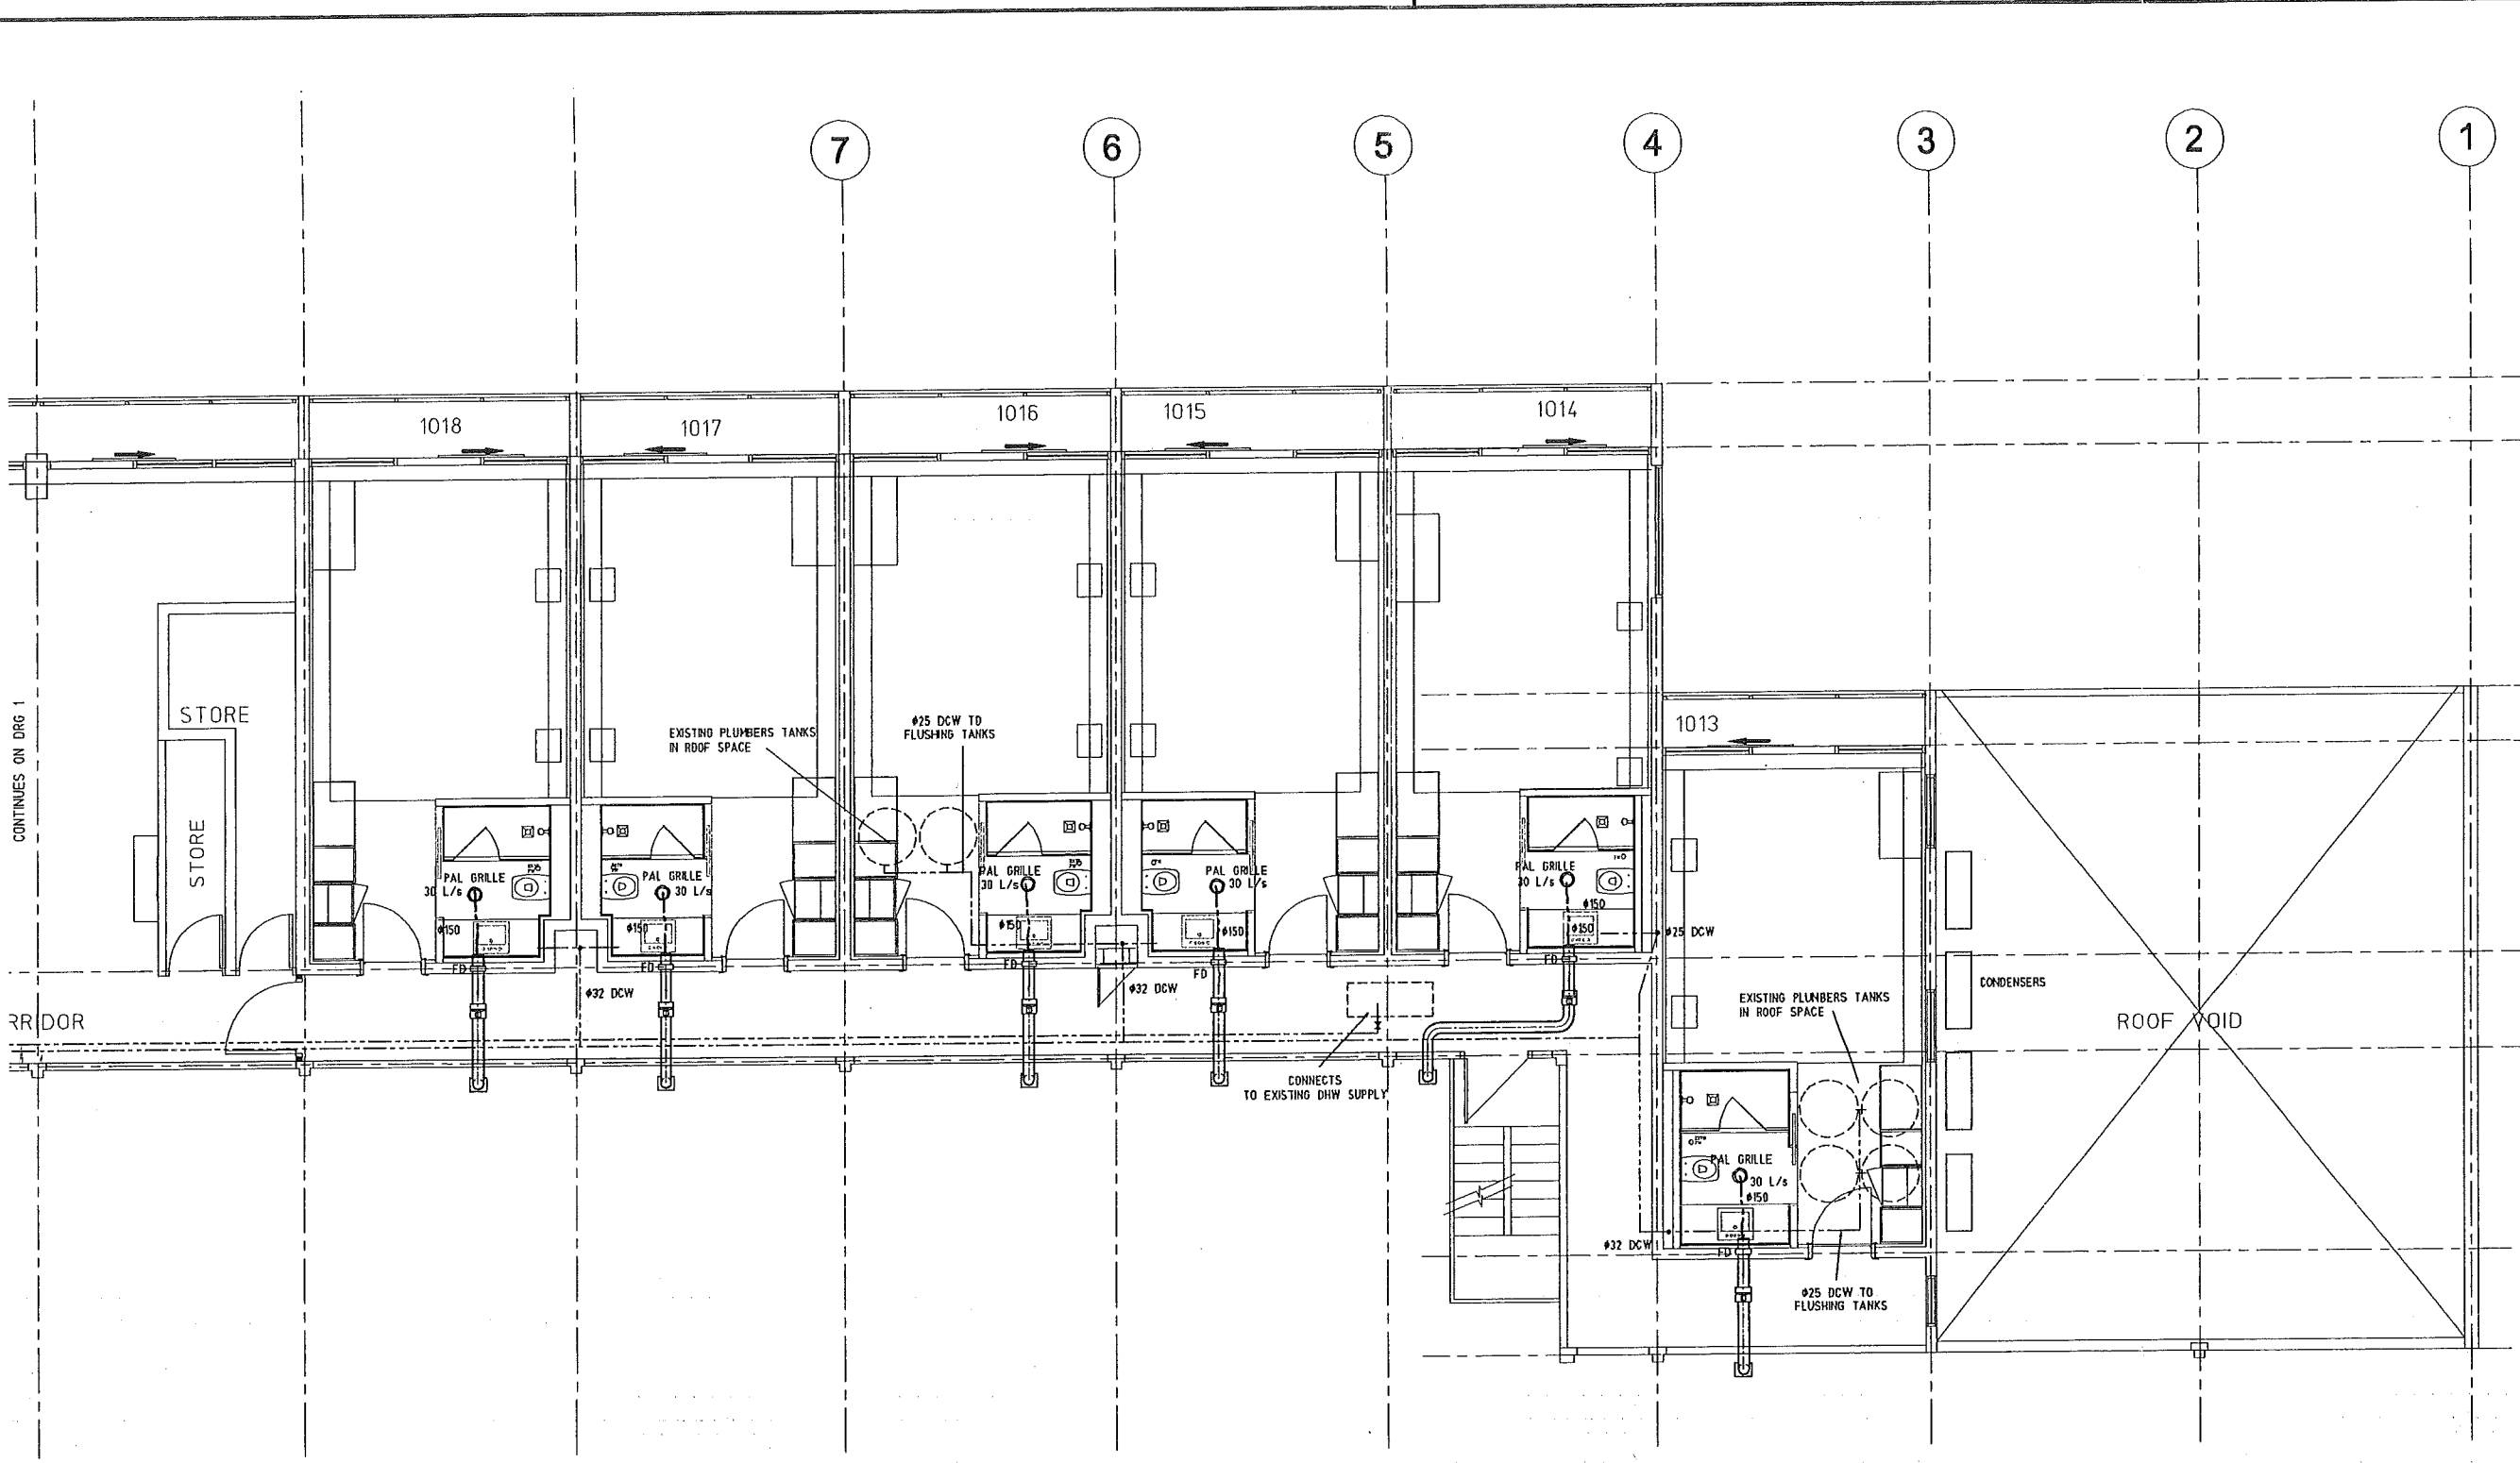

Issue	Amendments	Date	Sign

M
N

P1
P2

R
S

AS BUILT DRAWING
DECEMBER 2007
THIS DRAWING IS A TRUE AND ACCURATE RECORD OF THE AS INSTALLED MECHANICAL SERVICES SYSTEM
Signed WH

Stamp: AS BUILT DRAWING		
Status of Drawing	Authorized Sign	Date
PRELIMINARY -		
FOR APPROVAL -		
FOR CONSTRUCTION -		

COPYRIGHT*
This Document and the Copyright in this Document remain the Property of Economech Services Ltd. The Contents of this Document may not be reproduced either in whole or in part, by any means whatsoever without the prior written consent of Economech Services Ltd.

ECONOMECH SERVICES LTD
P.O. BOX 14018 PANHURE, AUCKLAND, NZ
Ph: (09) 579-1444, Fax: (09) 579-2308
Email: aircon@economech.co.nz

AIR CONDITIONING, REFRIGERATION & HEATING ENGINEERS

Project Title:
**KINGSGATE
ORIENTAL BAY
WELLINGTON**

Sheet Title:
**MECHANICAL SERVICES
ROXBURGH WING
LEVEL 10 PART 2**

Drawn: **RC** cad file: 1404-R10.dwg

Date: **OCT'07** Scale at A1: 1:100
Scale at A3: 1:200

Drawing No: **1404-R10-2**

Wellington City Council
21 April 2021