


1A.



new layout west wing. see 1B.

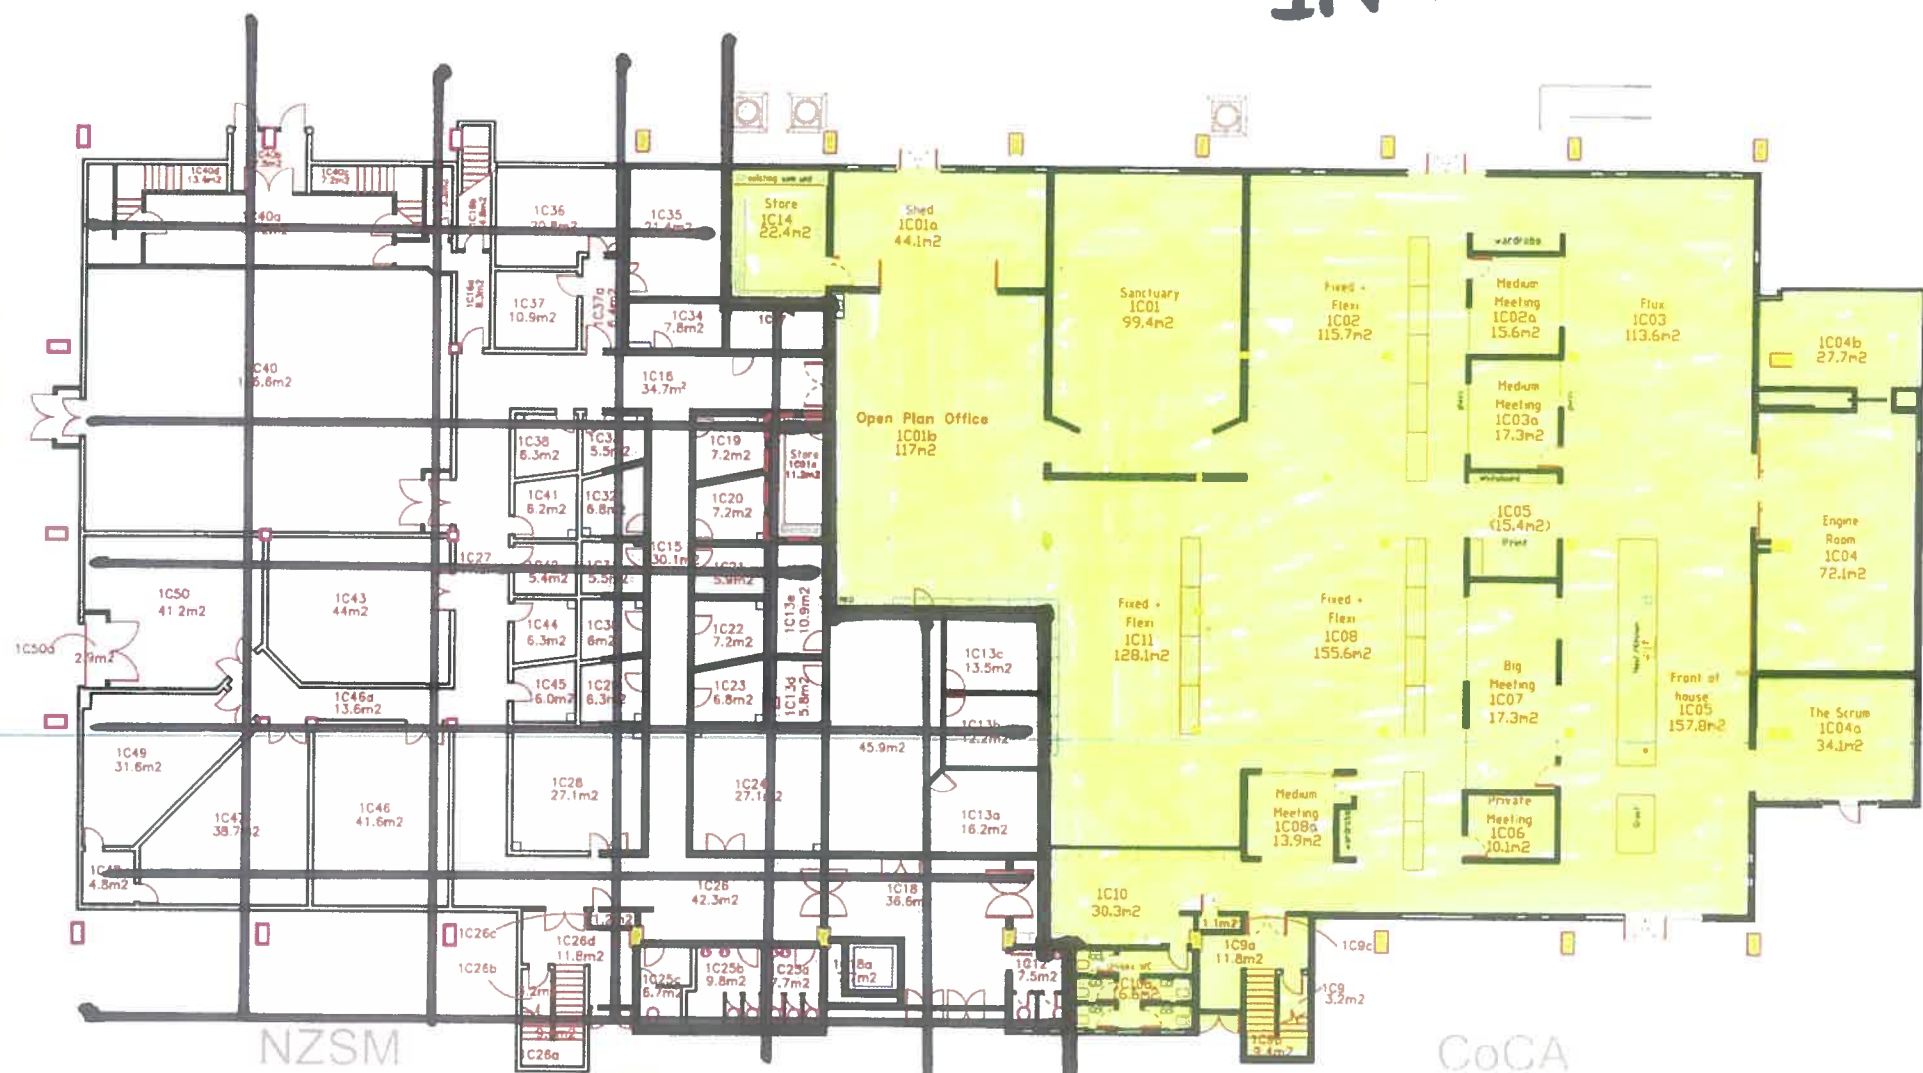

BUILDING BLOCK 1 FLOORS Lvl C
 PLAN BASIC FLOOR PLAN

Scale	1:100
North	North
Revision	1/1

Wellington City Council Received: 20/09/2022

1B.

See 1A floor plan.
East wing.



Furniture Floor Plan - Level C

STRUCTURAL ENGINEER
NAME: CBP
PH:
FAX:
PO BOX:
EMAIL:

SERVICES ENGINEER
NAME: GHD
PH:
FAX:
PO BOX:
EMAIL:

FIRE ENGINEER
NAME: Holmes Fire & Safety
PH:
FAX:
PO BOX:
EMAIL:



SYMBOLS
B: Basic Jump
C: Call or Jump
H: Handrail

athfield
architects
limited

School of Music & CMP
Furniture Floor Plan - Level C
1:100 @ A1

15-28
A10.00-A

Wellington City Council Received: 20/09/2022

2.




BUILDING: BLOCK 1 FLOOR: Lvl D
PLAN: BASIC FLOOR PLAN

Amtd By	Facilities Management
Date	13-01-2013
Scale	A3 - Scale 1:100
File Name	BK1 Lvl D.dwg

Wellington City Council Received: 20/09/2022

3.

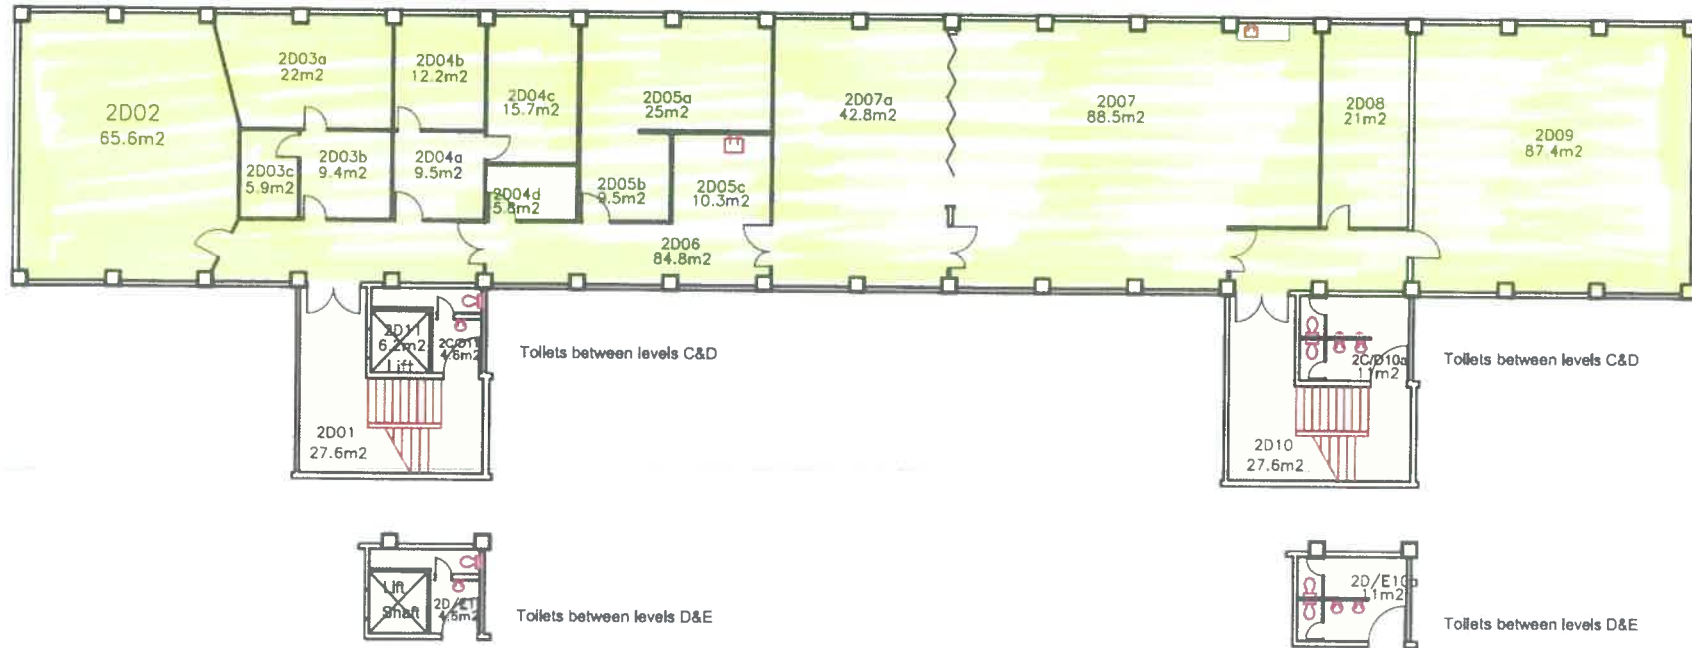

MASSEY UNIVERSITY

BUILDING: BLOCK 2


FLOOR: Lvl D

PLAN: BASIC FLOOR PLAN

Author:	Facilities Management
Date:	06/07/2011
Scale:	A4 - Scale 1:250
File Name:	BF-2 LvlD.rwg

Wellington City Council Received: 20/09/2022

4.

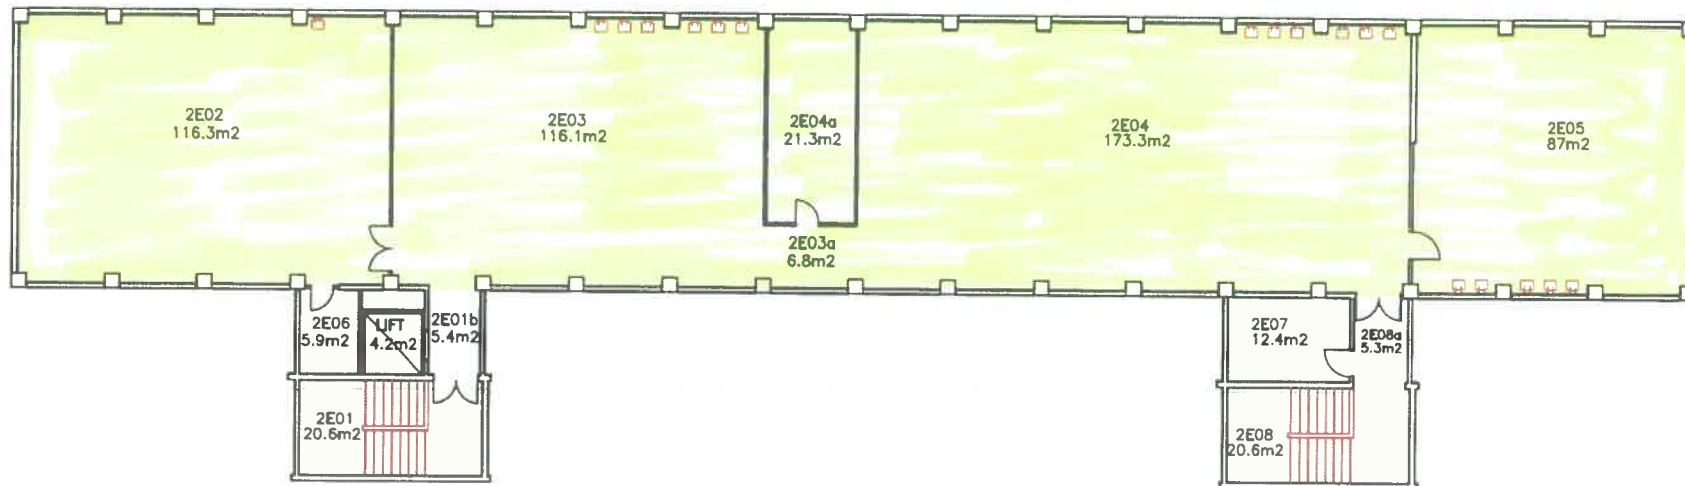

MASSEY UNIVERSITY

BUILDING: BLOCK 2

FLOOR: Lvl E

PLAN: BASIC FLOOR PLAN

Authr By	Facilities Management
Date	28/06/2013
Scale	A4 - Scale 1:250
File Name	Blk2 LvlE.dwg

Wellington City Council Received: 20/09/2022

5.




BUILDING: **BLOCK 5** FLOOR: **LEVEL A**
 PLAN: **BASIC FLOOR PLAN**

Auth: By	Facilities Management
Date	02/01/2014
Scale	(A4 - 1:30)
File Name	BF5 - JVA.dwg

Wellington City Council Received: 20/09/2022

6.

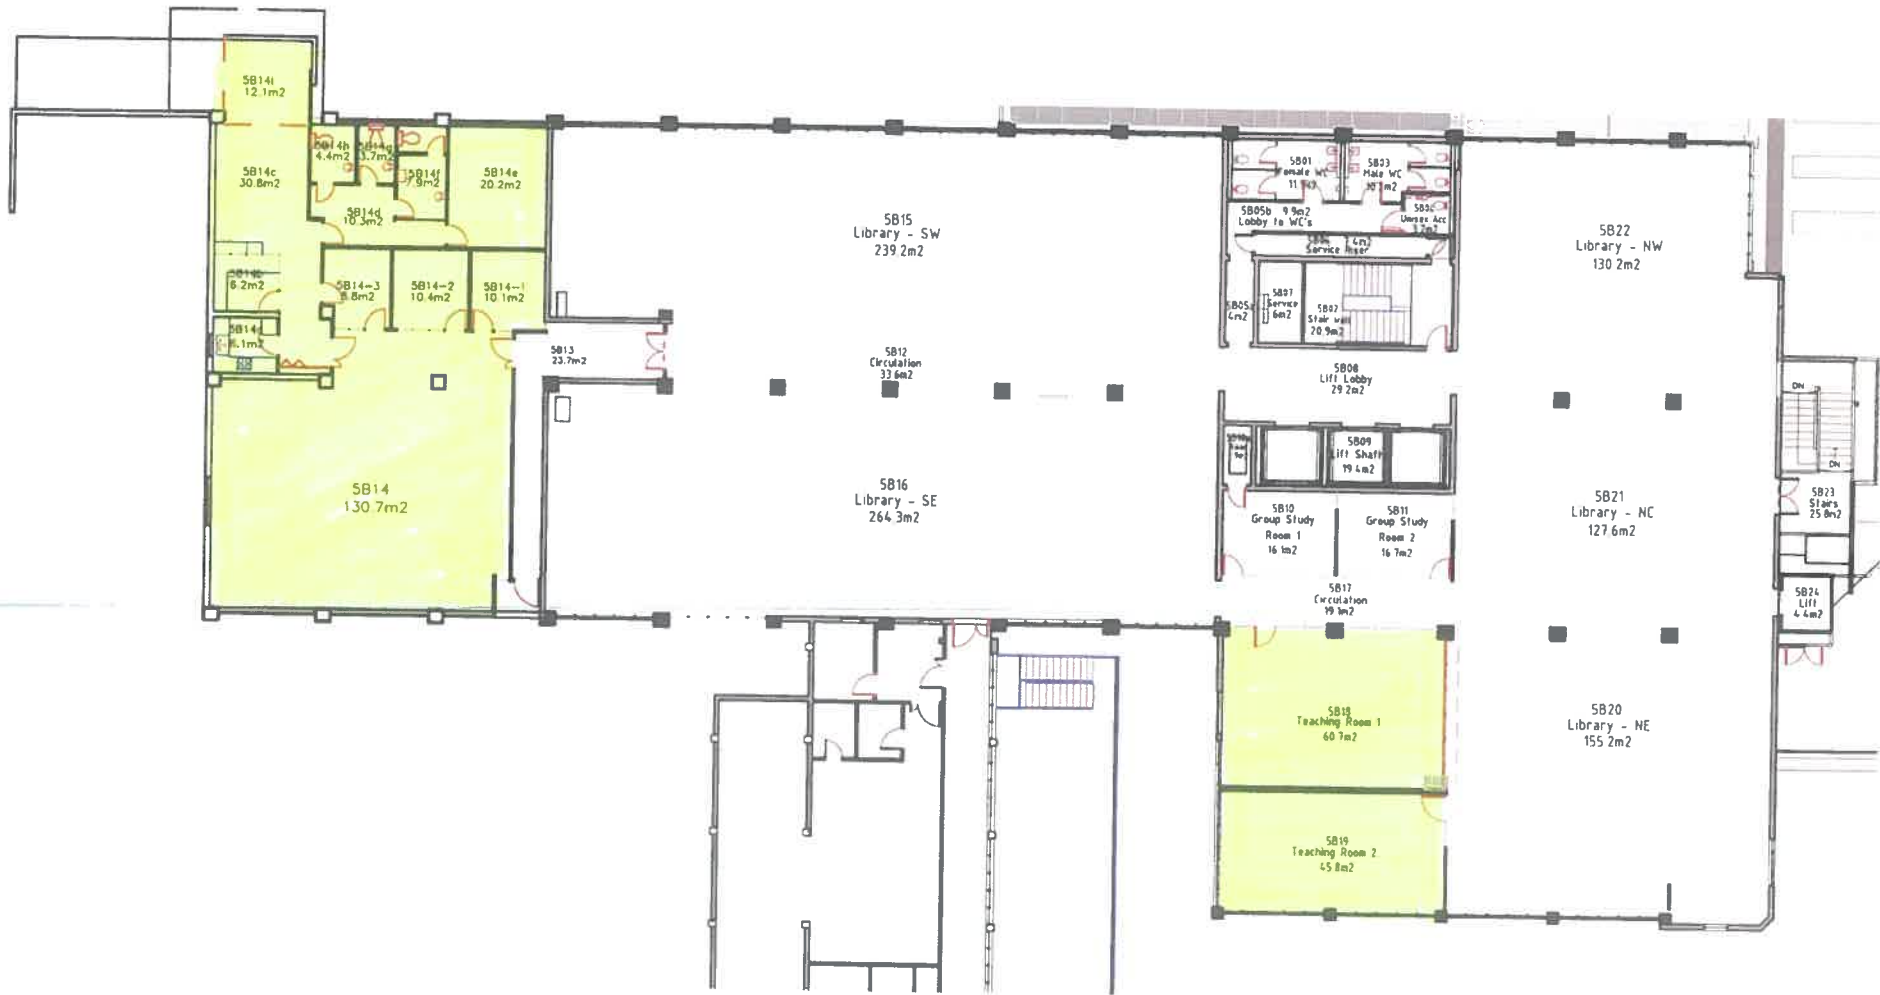


BUILDING: BLOCK 5 FLOOR: Lvl B
PLAN: BASIC FLOOR PLAN

Drawn By	Facilities Management
Date	31/12/2013
Scale	A4 - 1:100
File Name	BR5 Lvl B.dwg

Wellington City Council Received: 20/09/2022

7.

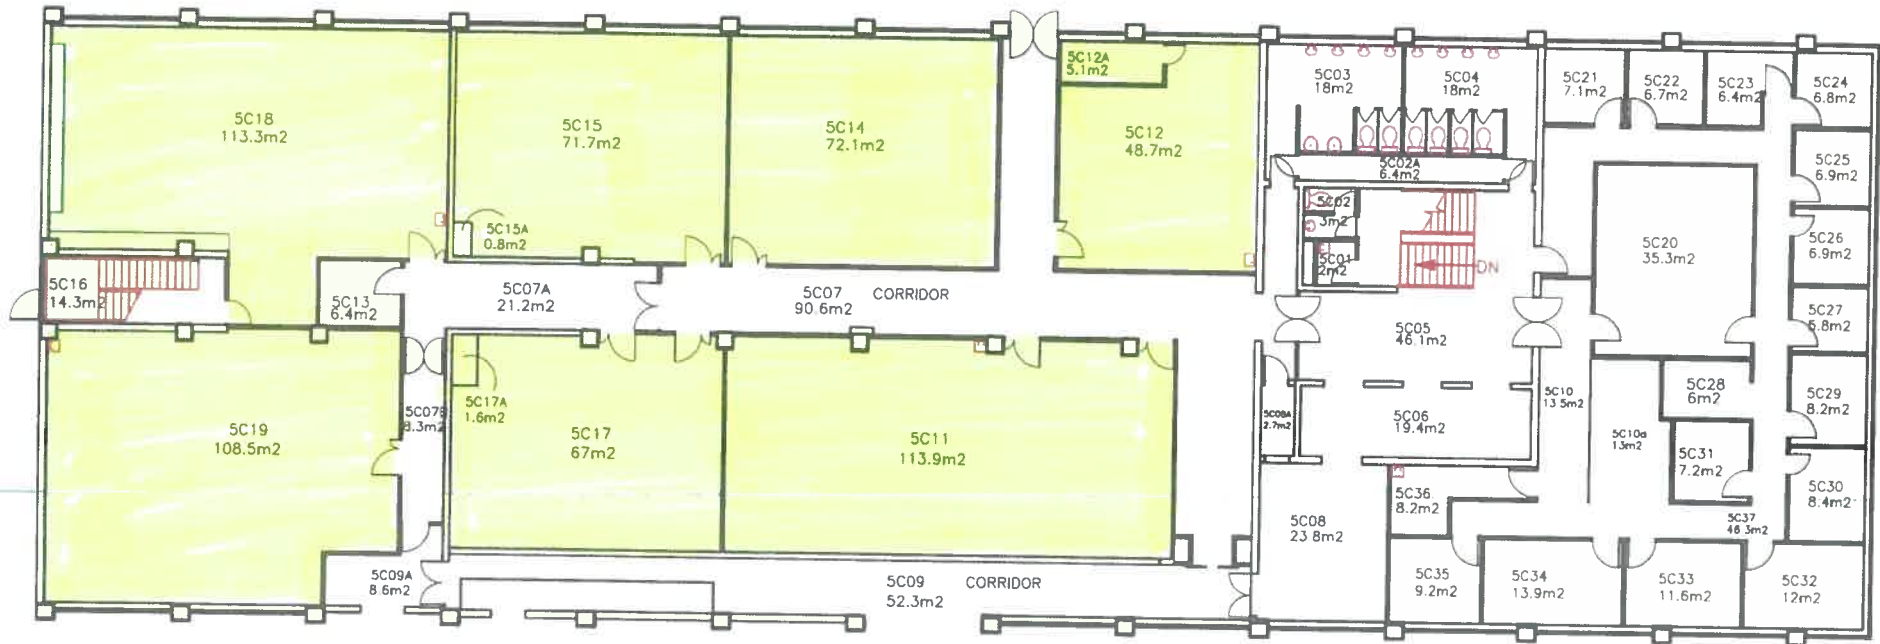

MASSEY UNIVERSITY

BUILDING: BLOCK 5

FLOOR: Lvl C

PLAN: BASIC FLOOR PLAN

Area no.	Facilities Management
Date	24-01-2013
Scale	A4 - Scale 1:50
File Name	BLK5 Lvl C.dwg

Wellington City Council Received: 20/09/2022

8.




BUILDING: BLOCK 5 FLOOR: LVL D
PLAN: BASIC FLOOR PLAN

Am: Bv	Facilities Management
Date	04/03/2014
Scale	A4 - Scale 1:250
File Name	Blk5 LvlD.dwg

Wellington City Council Received: 20/09/2022

9.

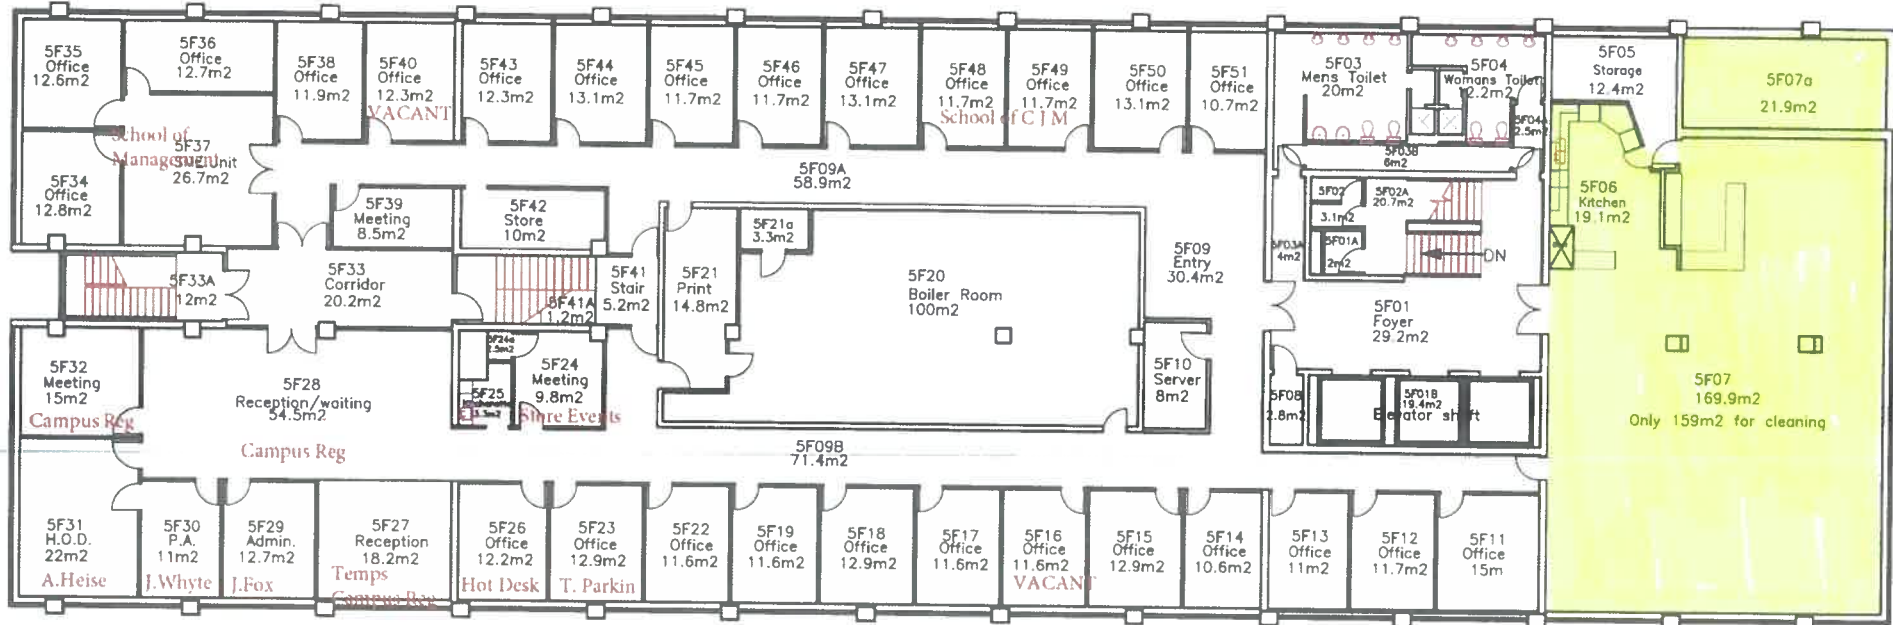

MASSEY UNIVERSITY

BUILDING: BLOCK 5


FLOOR: Lvl F

PLAN: BASIC FLOOR PLAN

Author:	Facilities Management
Date:	27/08/2011
Scale:	A4 - Scale 1:250
File Name:	Blk5 LvlF.dwg

Wellington City Council Received: 20/09/2022


10

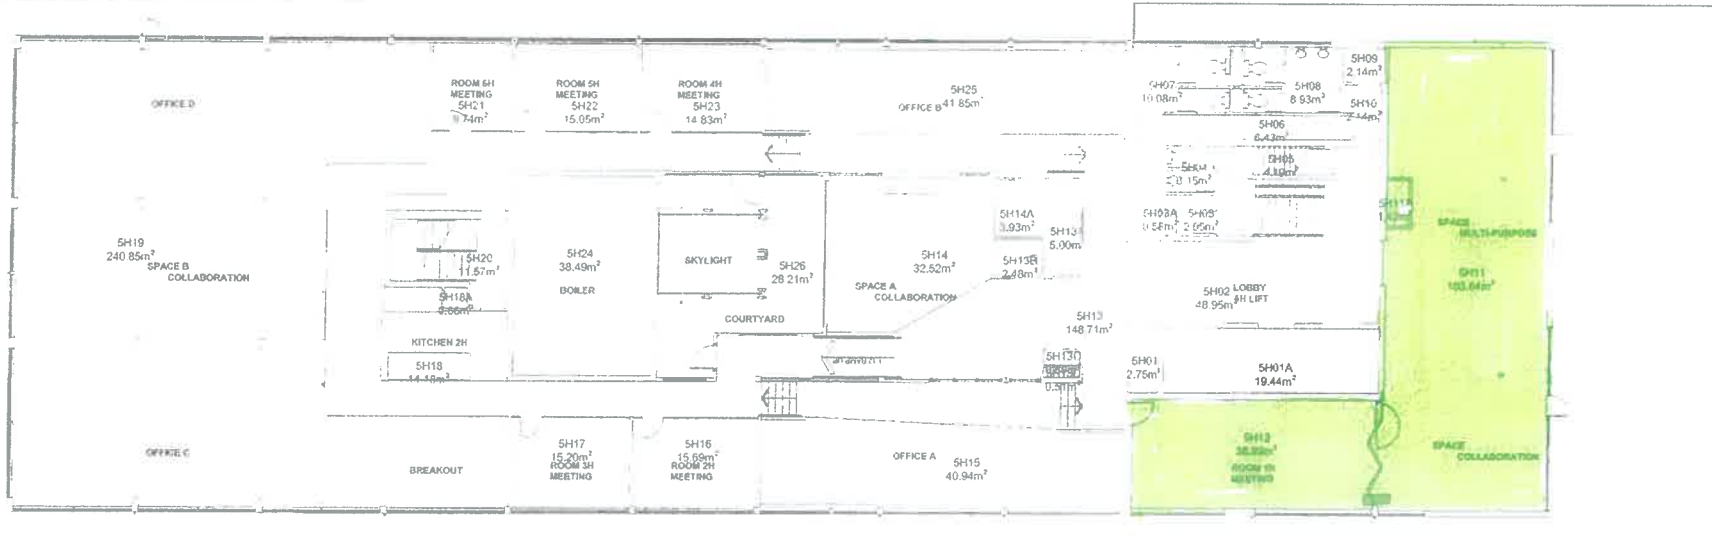

Block 5



Wellington City Council Received: 20/09/2022

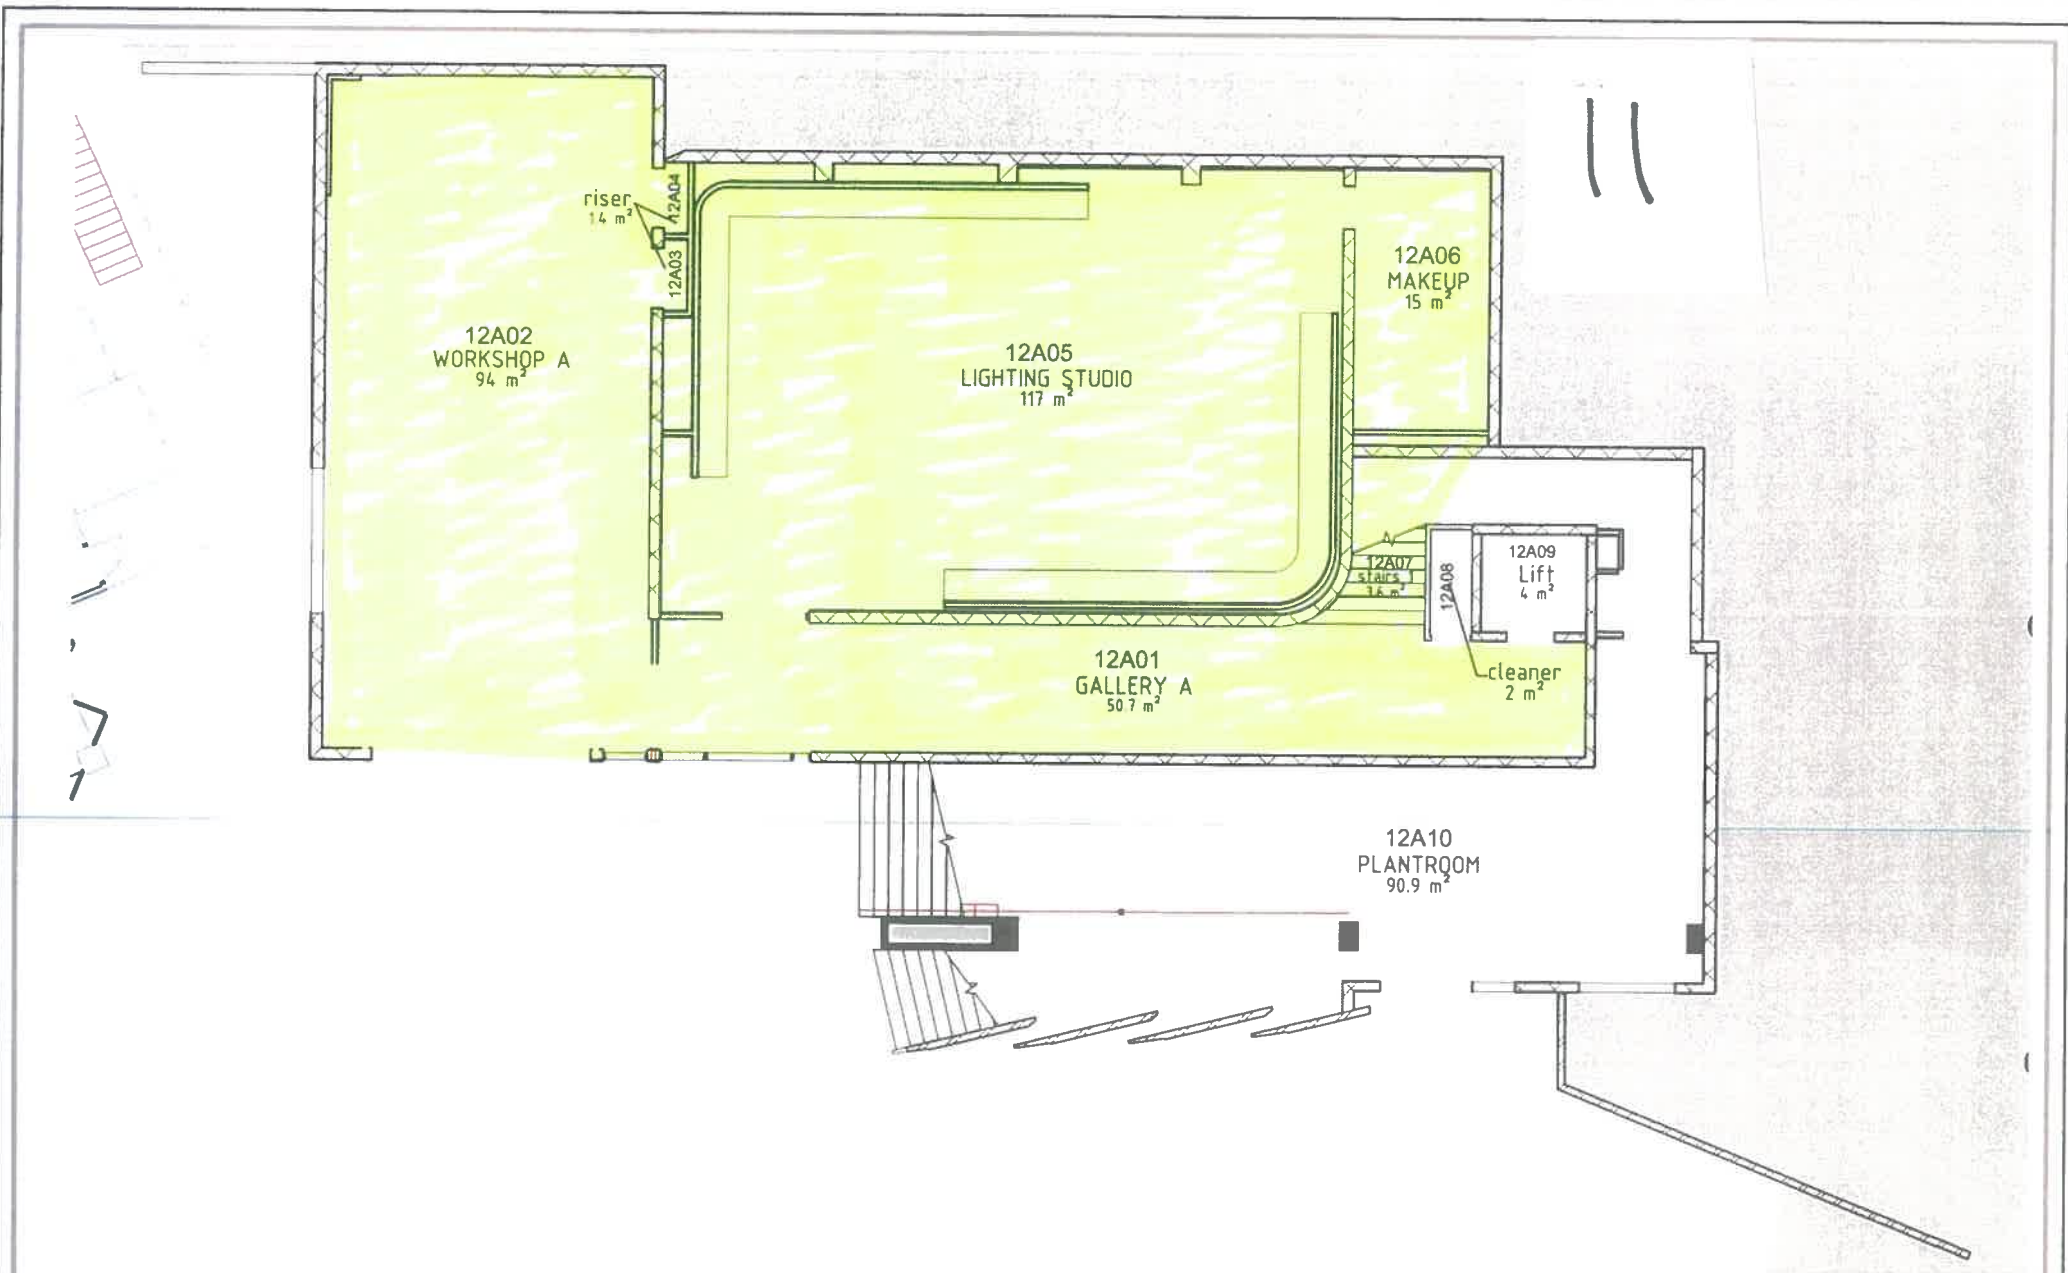


BUILDING: **BLOCK 12** LEVEL: **A**
 PLAN: **BASIC FLOOR PLAN**

Drawn By	Athfield Architects Ltd
Dwg For	Facilities Management
Date	05/06/2013
Scale	A4 - <Scale 1:150>
File Name	Blk12 LvlA-CoCA Numbering.dwg

Wellington City Council Received: 20/09/2022

12

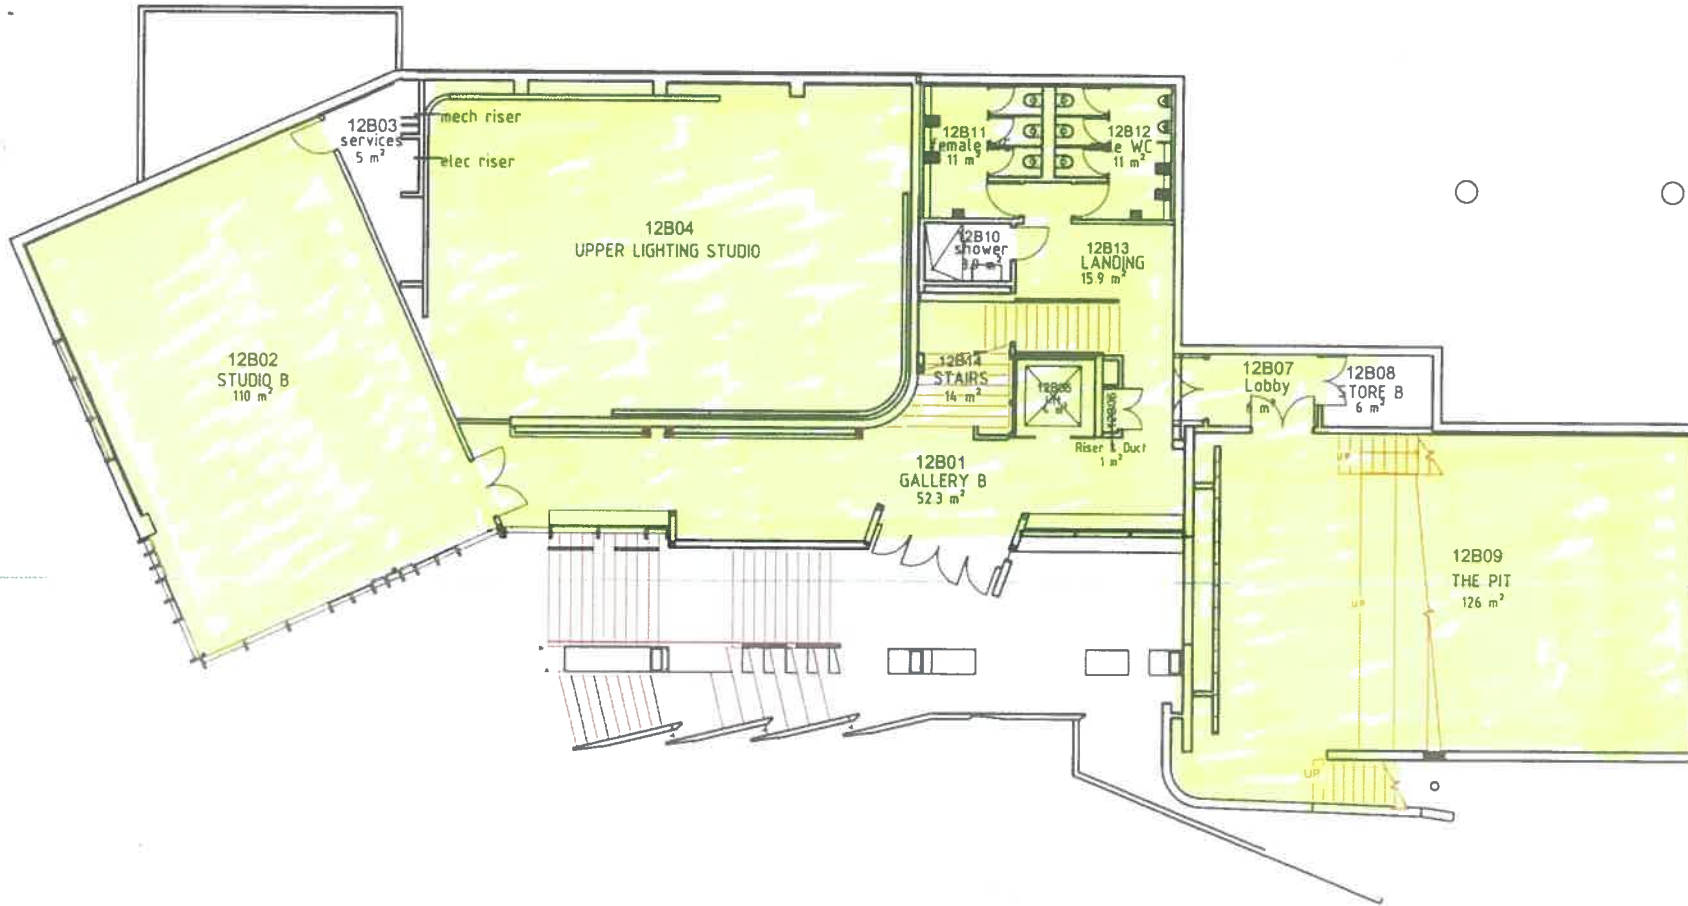

MASSEY UNIVERSITY

BUILDING: BLOCK 12



LEVEL: B

PLAN: BASIC FLOOR PLAN

Drawn By	Athfield Architects Ltd
Dwg For	Facilities Management
Date	28/06/2013
Scale	A4 - <Scale 1:200>
File Name	Blk12 LvlB.dwg

Wellington City Council Received: 20/09/2022

13

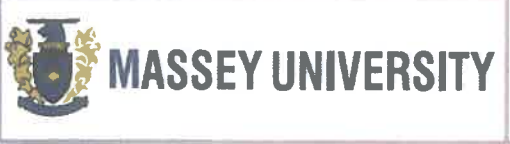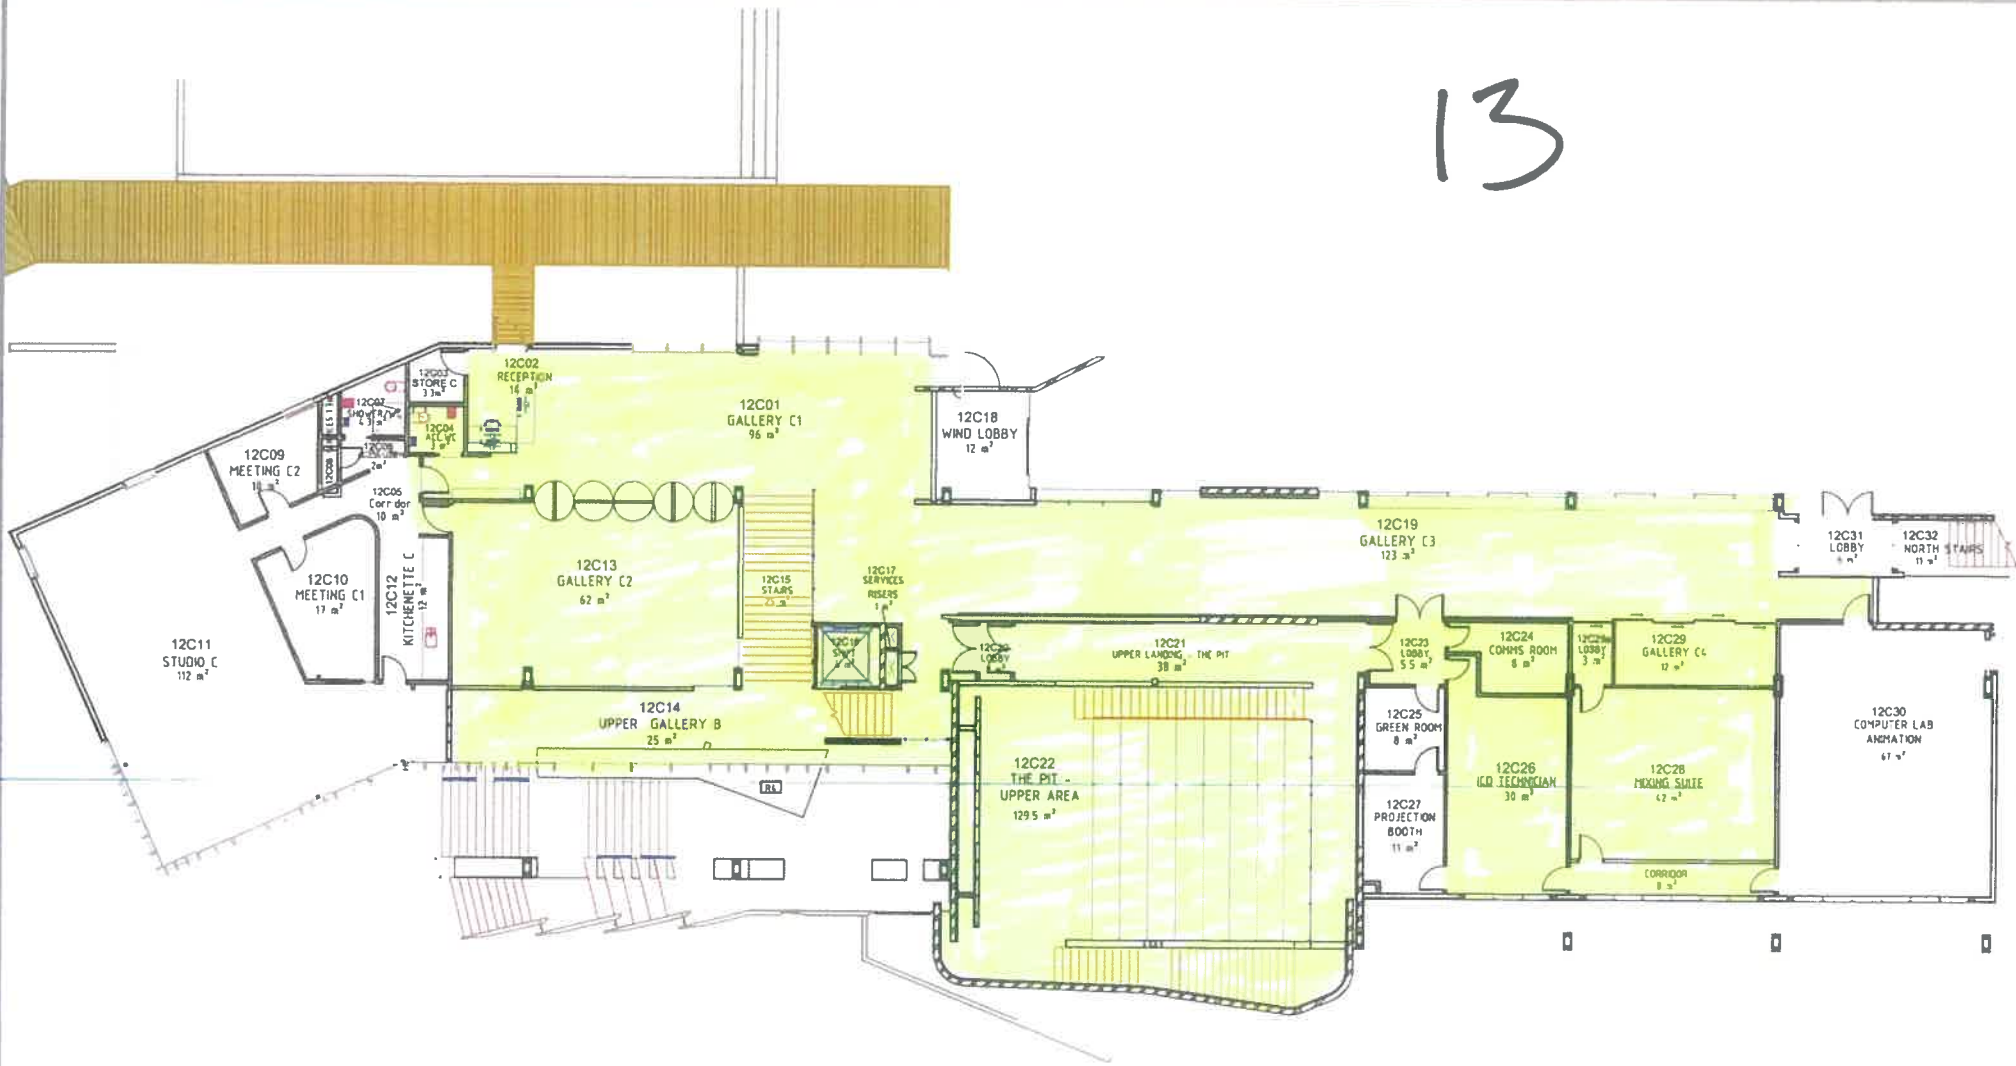

BUILDING: **BLOCK 12** LEVEL: **C**
 PLAN: **BASIC FLOOR PLAN**

Drawn By	Athfield Architects Ltd
Dwg For	Facilities Management
Date	13/06/2013
Scale	A4 - <Scale 1:250>
File Name	Blk12 LvlC.dwg

Wellington City Council Received: 20/09/2022

14




MASSEY UNIVERSITY

BUILDING: **BLOCK 12** LEVEL: **D**
PLAN: **BASIC FLOOR PLAN**

Drawn By	Athfield Architects Ltd
Dwg For	Facilities Management
Date	10/07/2013
Scale	A4 - <Scale 1:200>
File Name	Blk12 LvlD.dwg

Wellington City Council Received: 20/09/2022

15

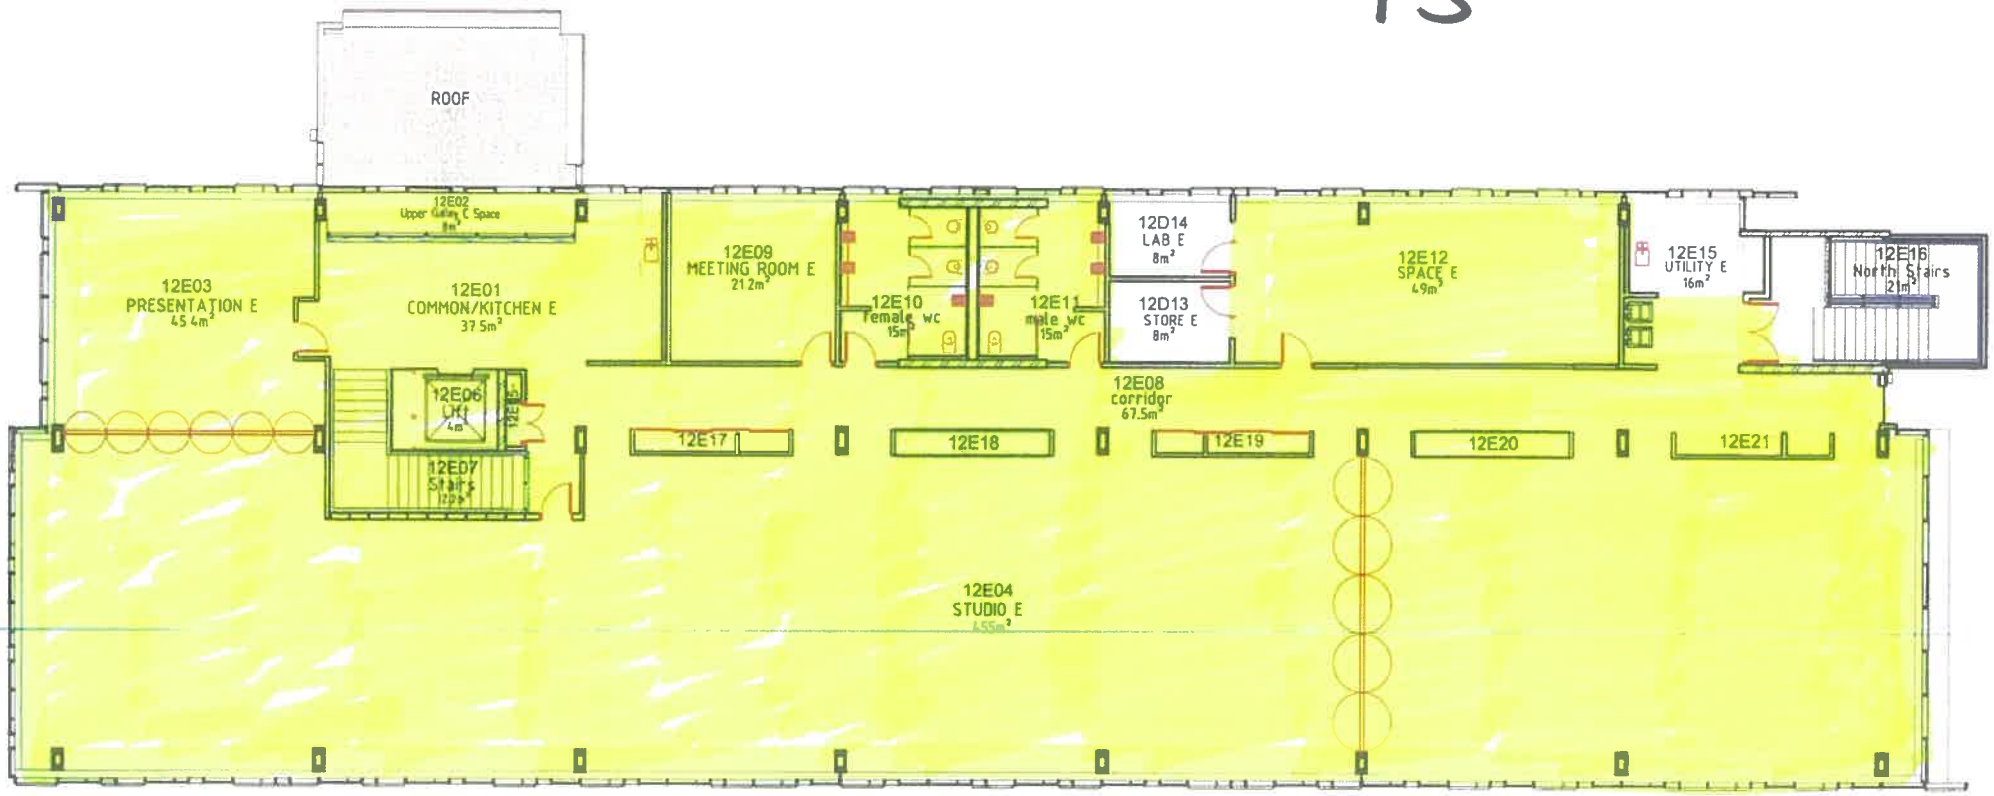


BUILDING: **BLOCK 12** LEVEL: **E**
PLAN: **BASIC FLOOR PLAN**

Drawn By	Athfield Architects Ltd
Dwg For	Facilities Management
Date	10/07/2013
Scale	A4 - <Scale 1:200>
File Name	Blk12 LvIE-CoCA Numbering.dwg

Wellington City Council Received: 20/09/2022


16

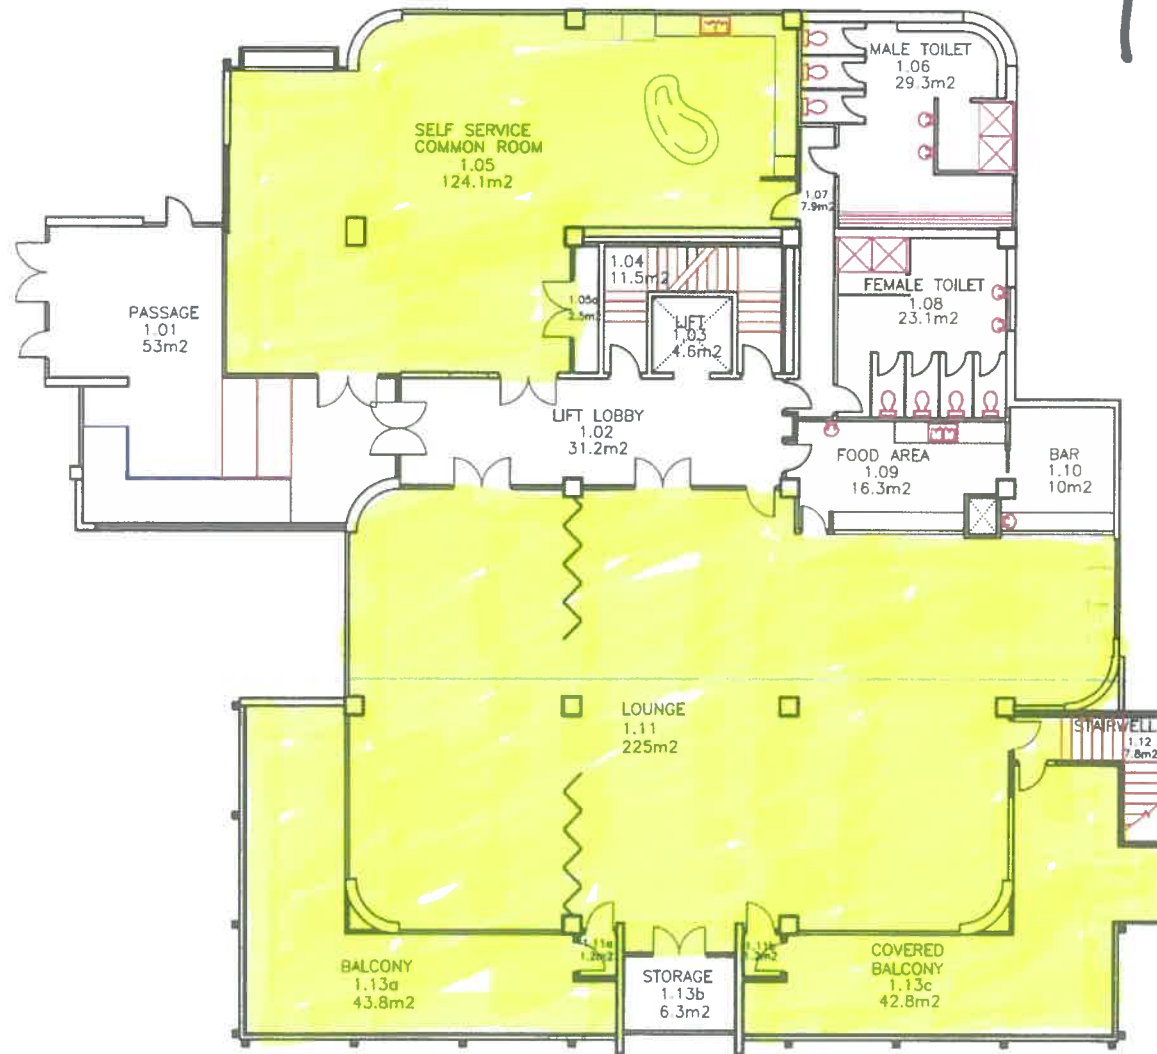

BUILDING: ~~SST~~ Block 9. FLOOR: ~~LVL~~ B.
PLAN: BASIC FLOOR PLAN

Drawn By:	Facilities Management
Date:	28/06/2011
Scale:	A4 - Scale 1:200
File Name:	SST LvlB.dwg

17

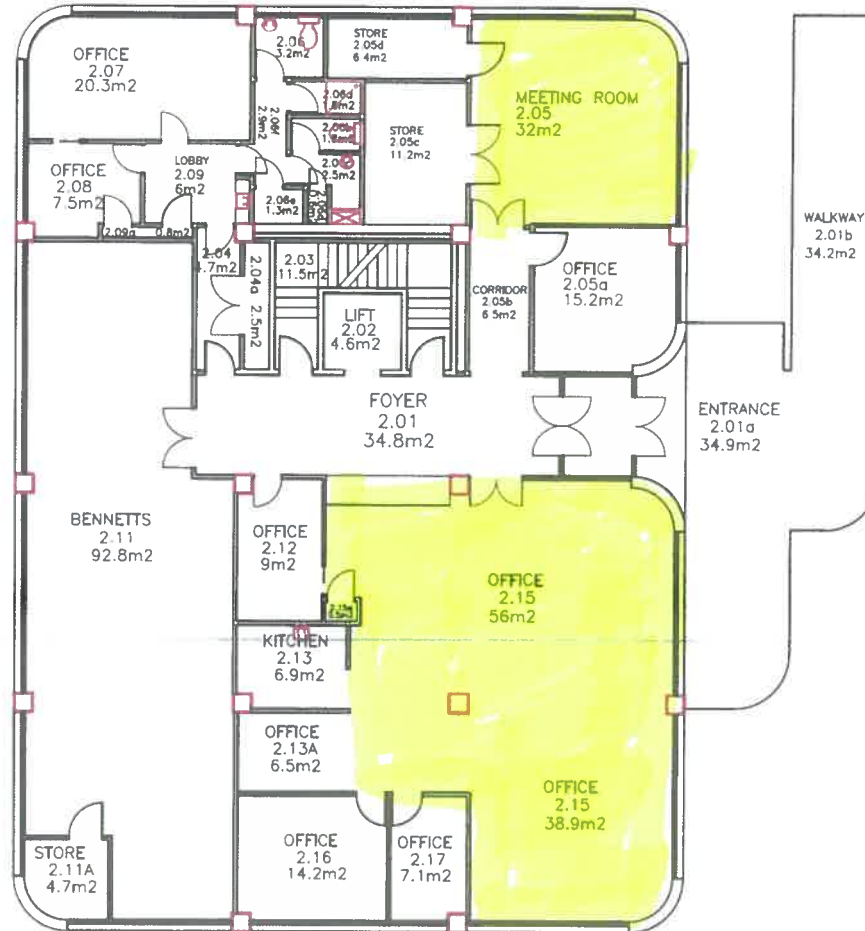

MASSEY UNIVERSITY

BUILDING:

~~SST~~ Block 9

FLOOR:

~~Lvl 2~~ C

PLAN:

BASIC FLOOR PLAN

Ampl By	Facilities Management
Date	09/09/2012
Scale	A4+ Scale 1:200
File Name	SST Lvl2.dwg

Wellington City Council Received: 20/09/2022


18



BUILDING: ~~SS1~~ **TUSSOCK** FLOOR: ~~Lvl G~~ **A.**
 PLAN: BASIC FLOOR PLAN

Prep By	Facilities Management
Date	20/07/2013
Scale	A4 Scale 1:100
File Name	SS1 Lvl G.dwg


Wellington City Council Received: 20/09/2022

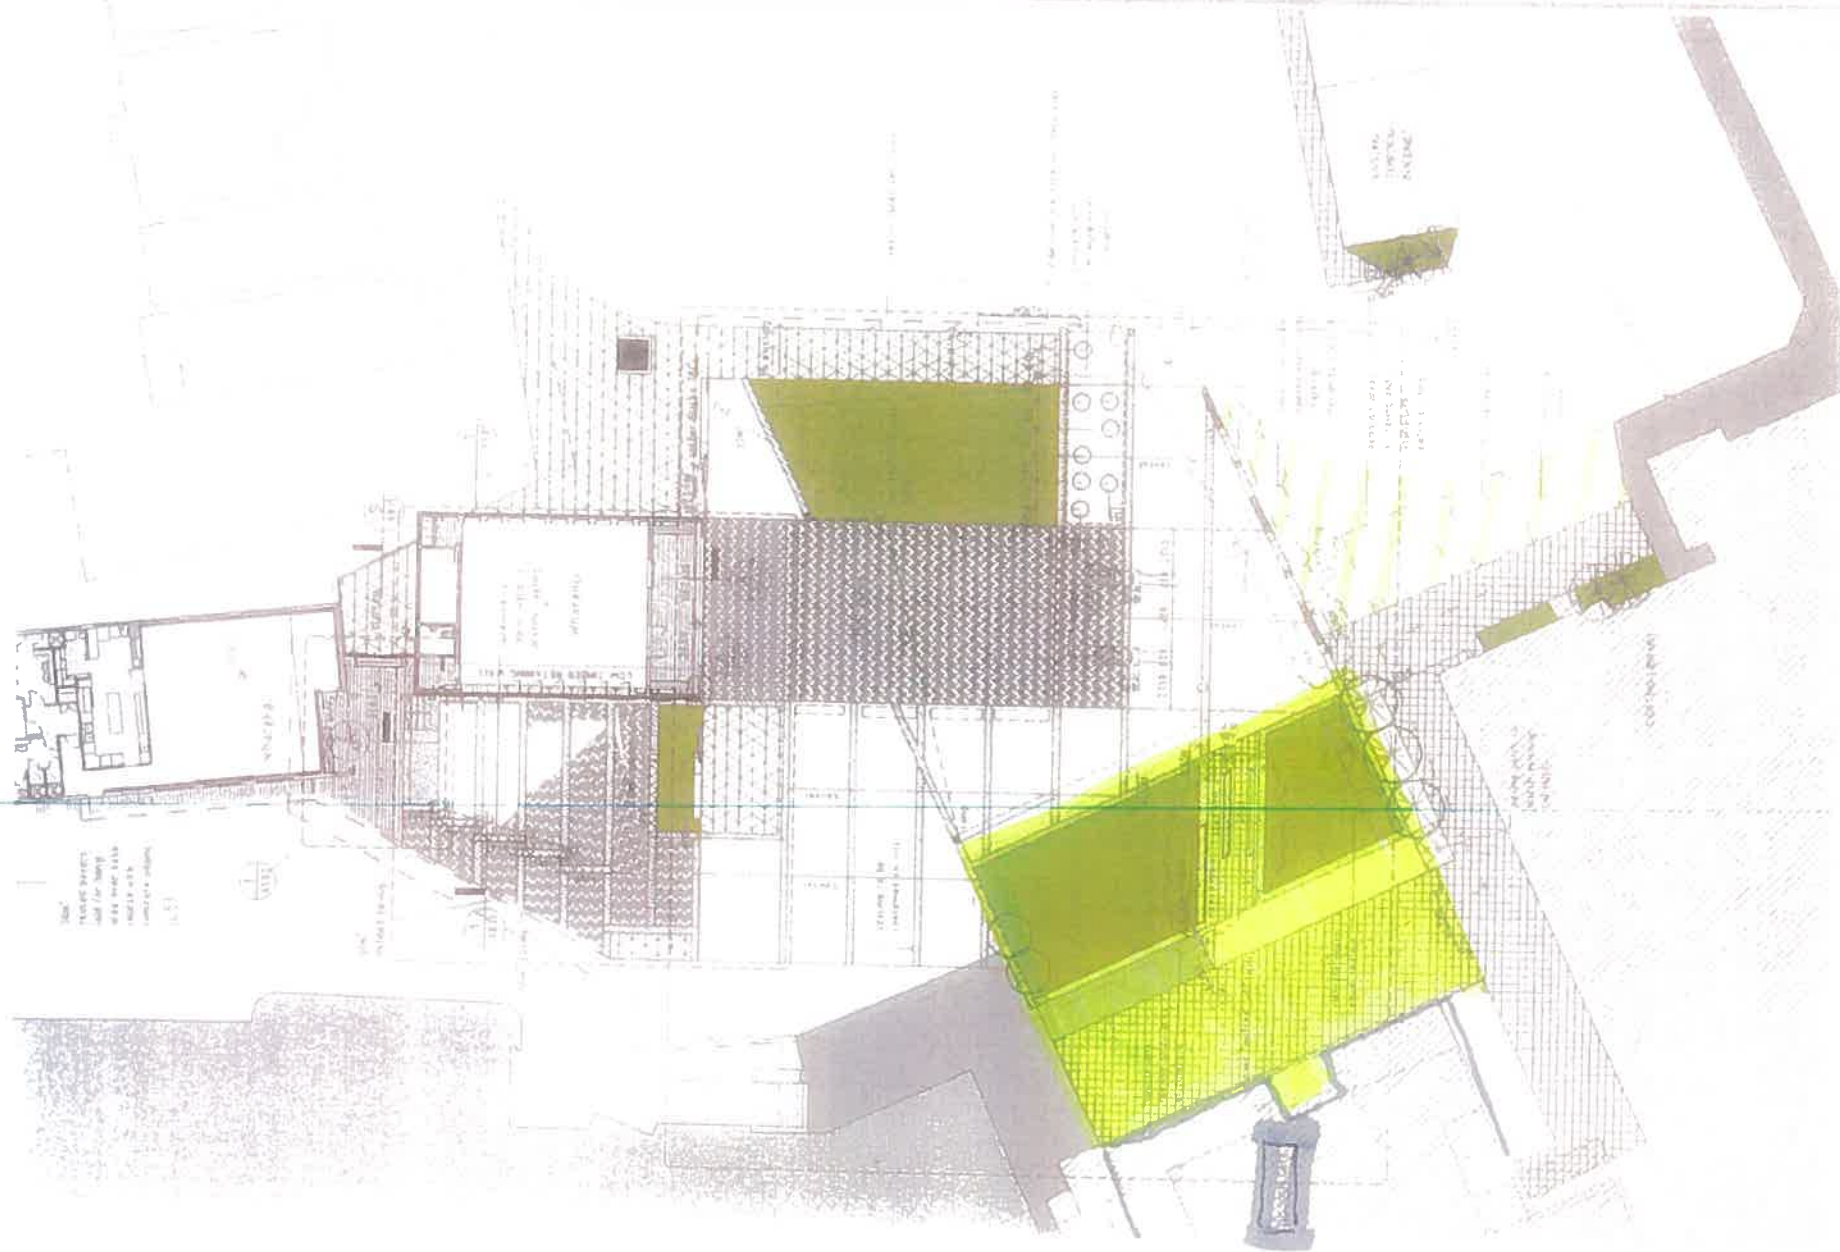

■ TUSOCK GATE INTERIOR FRONT
OUTSIDE AREA outside area

19.

20

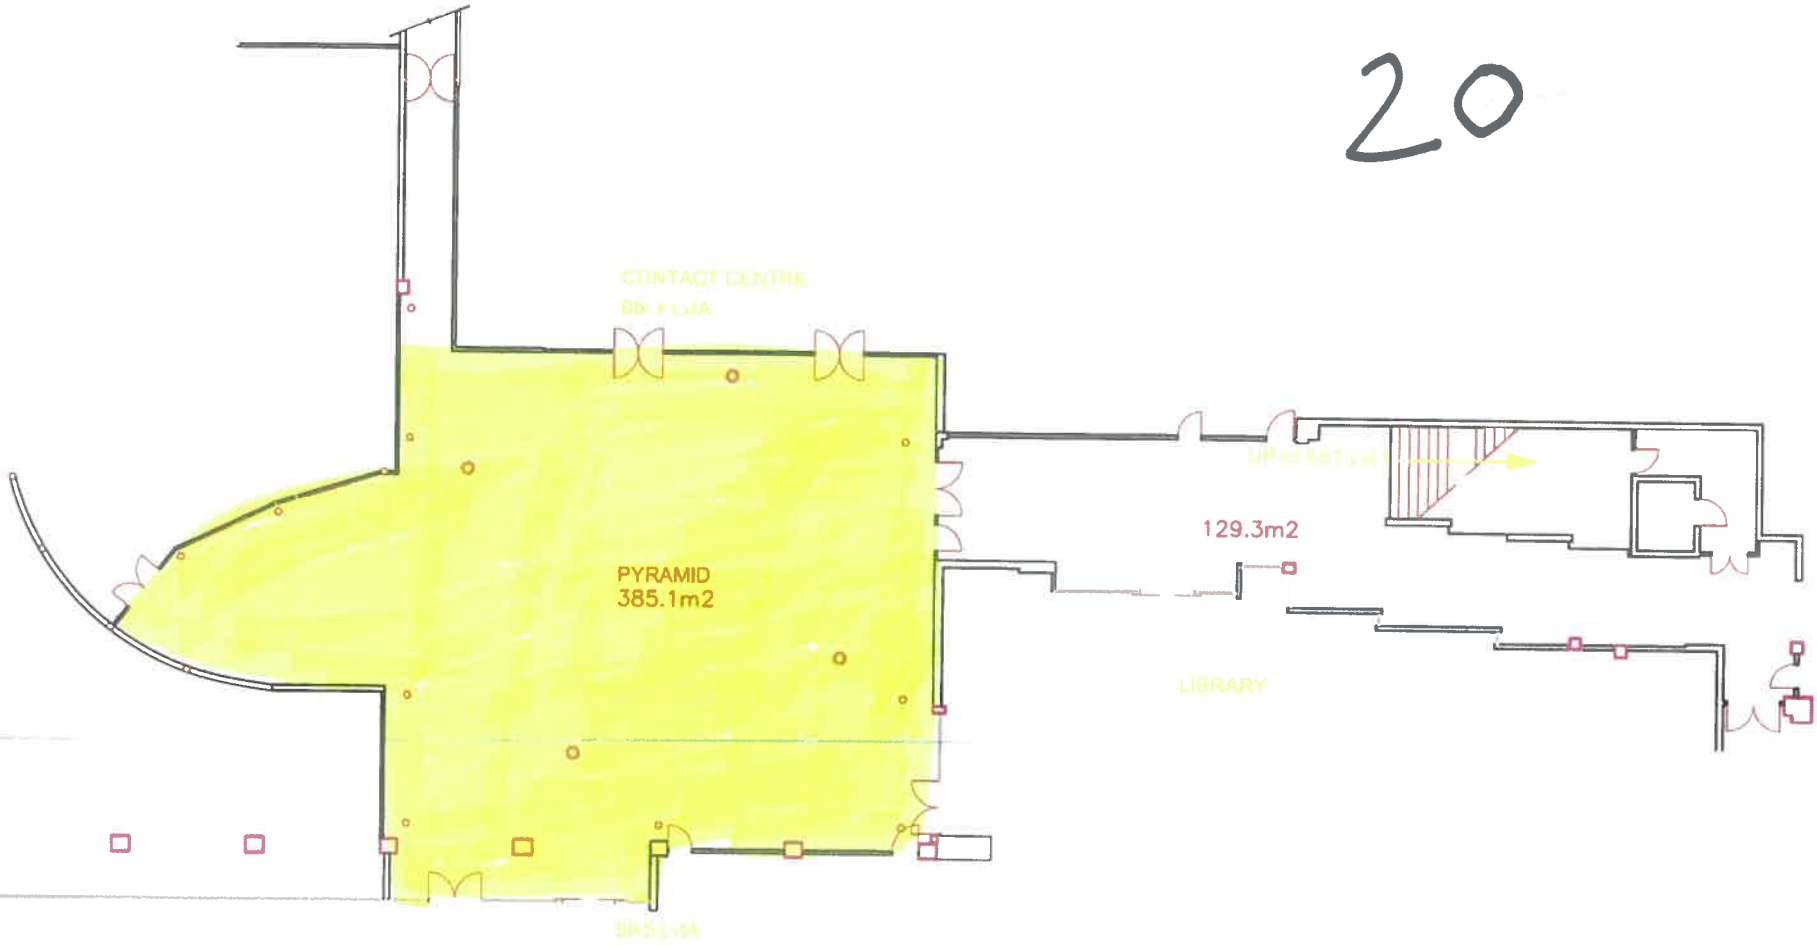

BUILDING: BLOCK 4-5 PYRAMID FLOOR: LVL A
PLAN: BASIC FLOOR PLAN

DATE	15/09/2022
BY	ARCHITECTURE
FOR	ARCHITECTURE
PROJECT	ARCHITECTURE

Massey University Alcohol Licence Renewal

Specific areas to be licenced with each building

(areas highlighted in green)

Floor Plan #	Building	Level	Likely Use of this space
1A	Block 1	C	Creative Arts Hospitality Area
1B	Block 1	C	Music Performance
2	Block 1	D	Large Scale Events
3	Block 2	D	Exhibition Space
4	Block 2	E	Exhibition Space
5	Block 5	A	Book Launches
6	Block 5	B	Conference Space / VIP Suite
7	Block 5	C	Conferencing
8	Block 5	D	Conferencing
9	Block 5	F	5F07 Functions
10	Block 5	H	5H Functions
11	Block 12	A	Events
12	Block 12	B	Events
13	Block 12	C	Exhibition
14	Block 12	D	Openings
15	Block 12	E	Openings
16	Block 9 (Formerly SST)	B	Meetings
17	Block 9 (Formerly SST)	C	Meetings / MAWSA Events
18 + 19	Tussock Café & Lawn	A	Café & Bar
20	Pyramid	A	Events / Conferencing